

RECEIVED


MAR 18 2022

OWRD

MAP TO ACCOMPANY WATER RIGHT TRANSFER APPLICATION


FOR
ERNEST & DIXIE SHUFFIELD
CHAYLON & AMBER SHUFFIELD

SECTIONS 23 & 24, TOWNSHIP 29 SOUTH,
RANGE 17 EAST, W.M.
LAKE COUNTY, OREGON

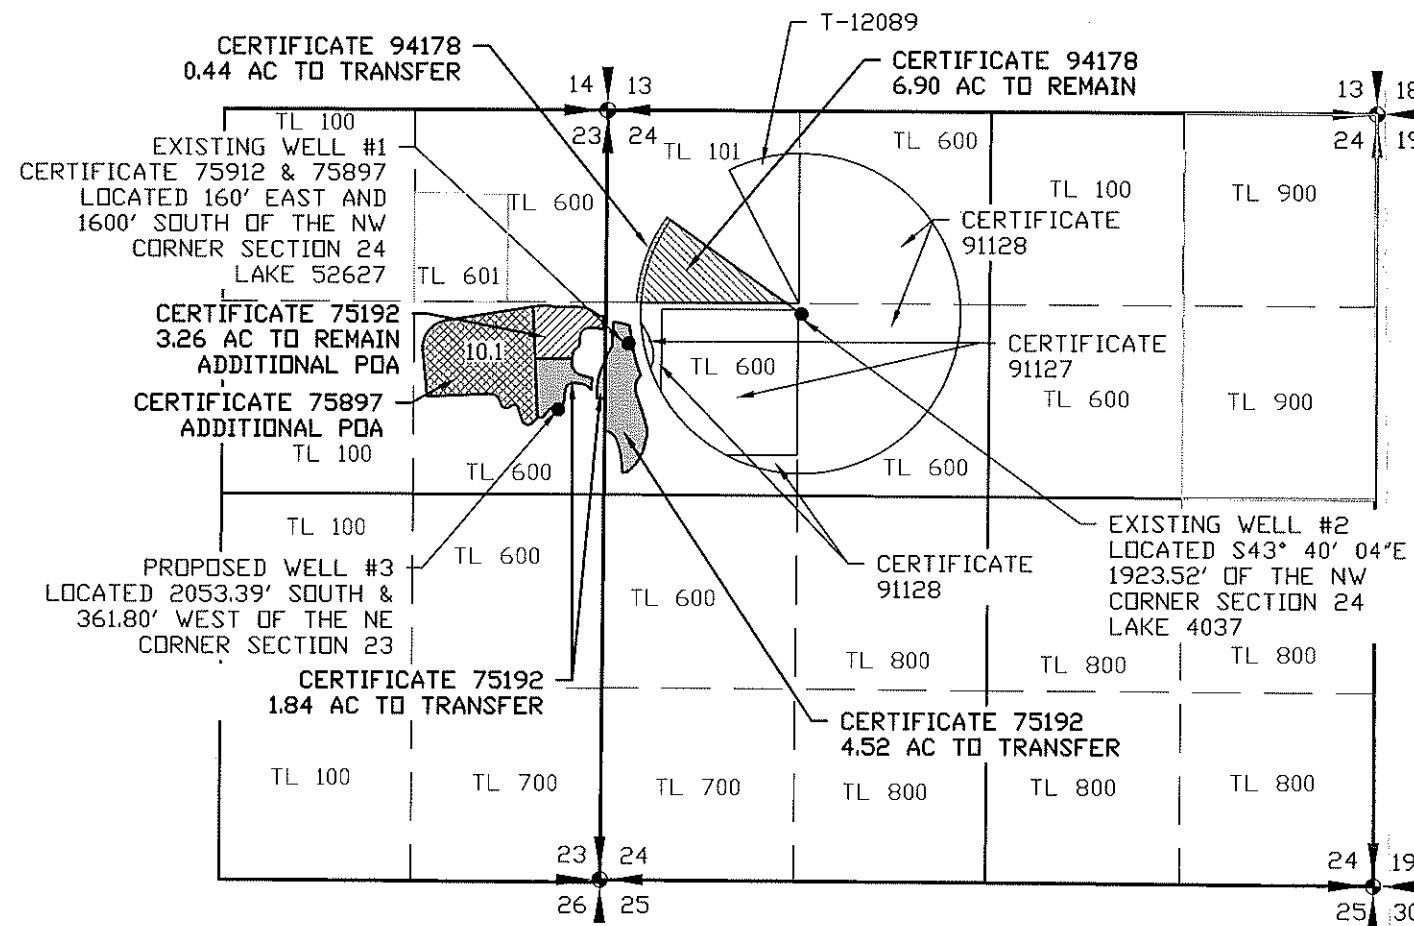

EXISTING

- | | |
|--|--|
| PLACE OF USE CERTIFICATE 75192
TO REMAIN, CHANGE POA - 3.26 ACRES | PROPOSED TRANSFER FROM
CERTIFICATE 94178 - 0.44 ACRES |
| PROPOSED TRANSFER FROM
CERTIFICATE 75192 - 6.36 ACRES | CERTIFICATE 94178 - WELL #1
CHANGE POA - 10.1 ACRES |
| PLACE OF USE CERTIFICATE 94178
TO REMAIN - 6.90 ACRES | |

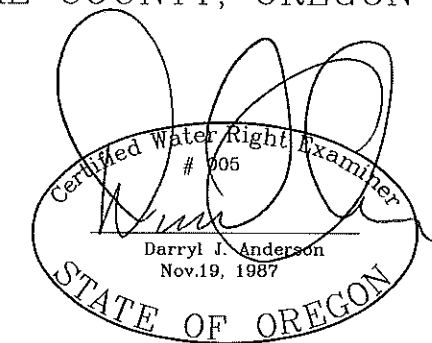

RENEWAL 12/31/23

LEGEND

- SECTION LINE
- 1/4 SECTION LINE
- 1/16 SECTION LINE
- TAXLOT LINE

SCALE: 1"=1320'

RECEIVED

MAR 18 2022

OWRD

TRANSFER NO. **13951**

NOTE:
PREPARATION OF THIS MAP IS FOR IDENTIFYING PROPOSED
WATER RIGHTS ONLY. IT HAS NO INTENT TO PROVIDE
LOCATIONS OR DIMENSIONS OF PROPERTY BOUNDARIES.

REVISION	BY
2-15-22	RC

ANDERSON ENGINEERING
AND SURVEYING, INC.
P.O. BOX 28
LAKEVIEW, OREGON 97630
(541) 947-4407
FAX: 947-2321


FOR:
CHAYLON SHUFFIELD
P.O. BOX 85
SUMMER LAKE, OR 97640

MAP TO ACCOMPANY WATER
RIGHT TRANSFER APPLICATION
SEC. 23 & 24, T29S, R17E W.M.

DATE:	2/9/2021
SCALE:	1" = 1320'
DWG. BY:	R.C.
JOB:	2021-015
FILE:	2021-015
SHEET:	1 of 2

CLAIM OF BENEFICIAL USE MAP
NW 1/4 Section 24, T.29S. R.17E., W.M.
 Lake County, Oregon


Transfer 11911

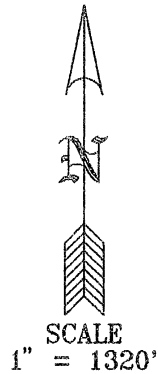



RECEIVED BY OWRD

OCT 08 2015

SALEM, OR

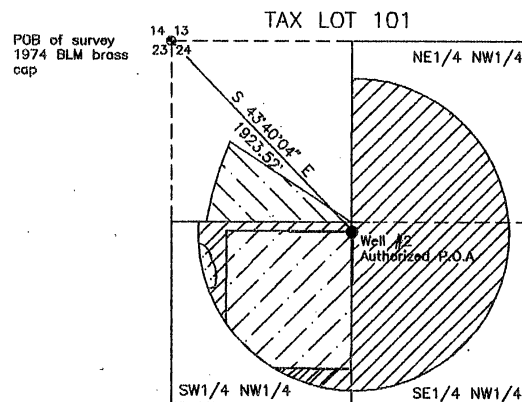


Measuring device is in pipe
between well & pivot

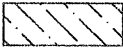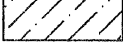-  7.34 Acres irrigated
Transfer 11911
-  52.42 Acres irrigated
Certificate 89770
-  20.97 Acres irrigated
Certificate 87464

Prepared for: Ernest D. & Dixie Shuffield
 Chaylon & Amber Shuffield
 Prepared by: Sundet & Associates
 P.O. Box 1228
 Lakeview, OR 97630

May 2015 DR #1419

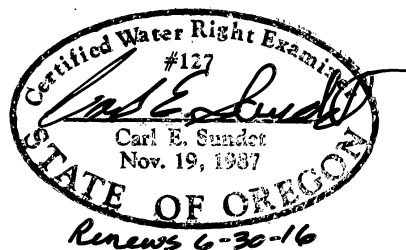

This map is for the purpose of identifying the location
 of the water right only and is not intended to provide
 legal dimensions or location of property ownership lines.