



# Looking Glass Organic Farms, LLC Claim of Beneficial Use (Cert. 37907 CN) Transfer T-13405

Township 28S, Range 7W, W.M.

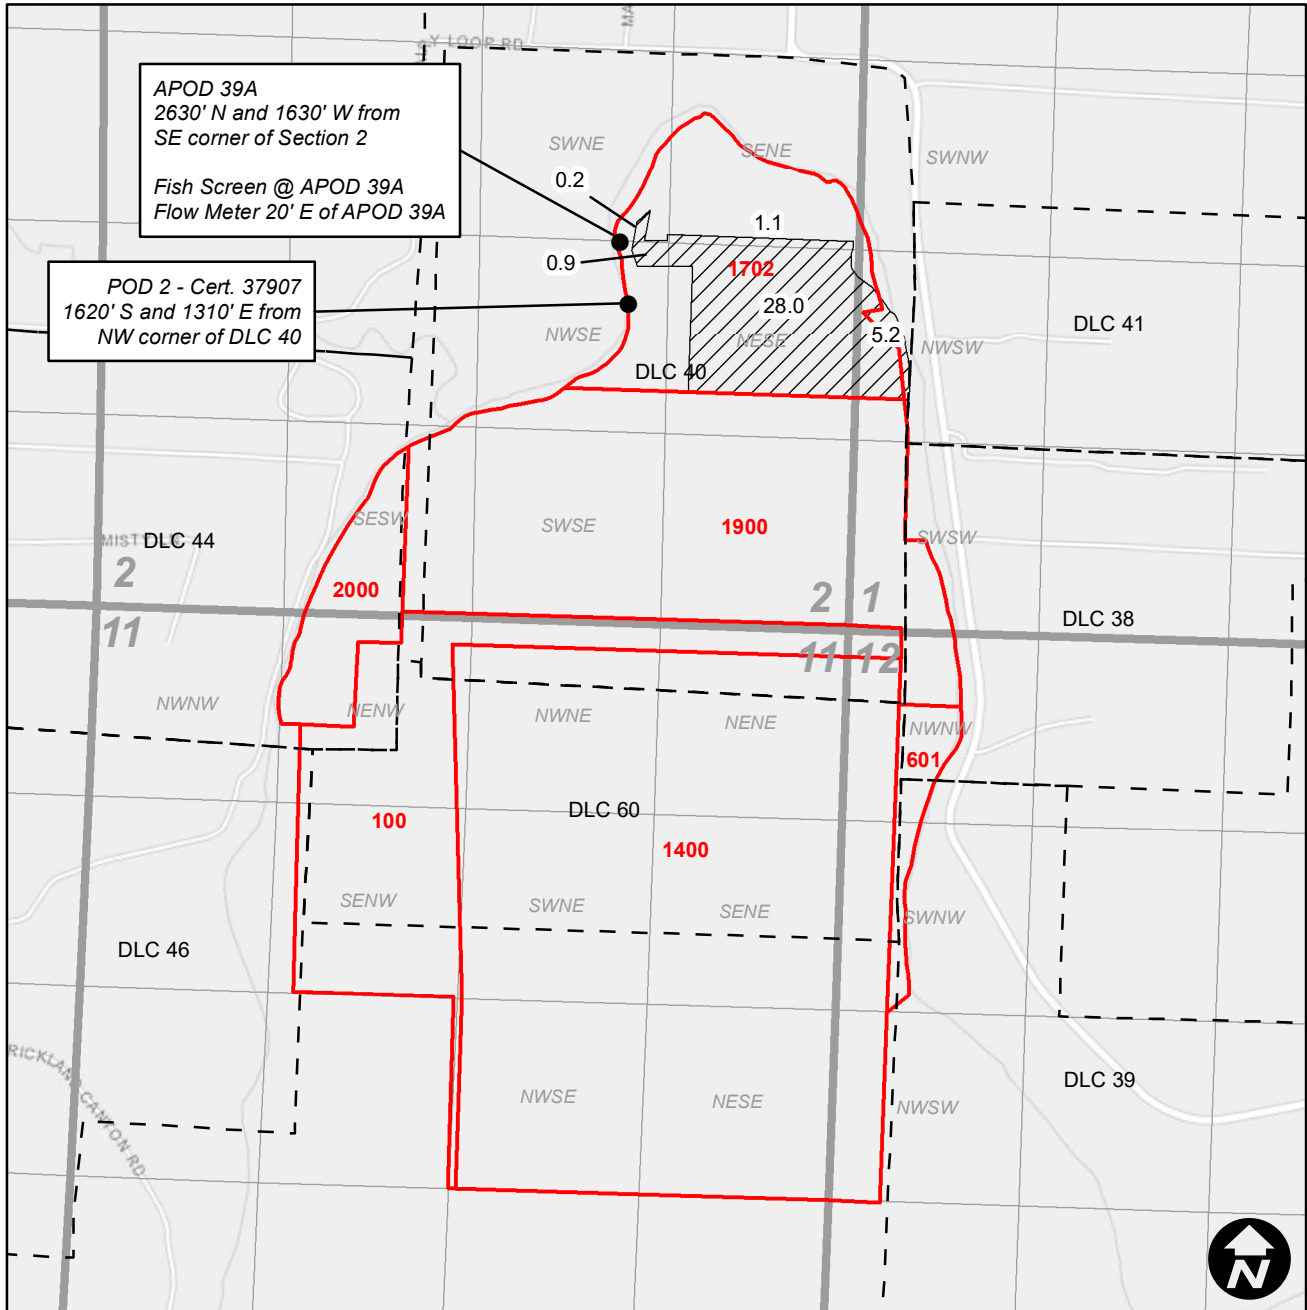

This map is not intended to provide legal dimensions or locations of property ownership lines.

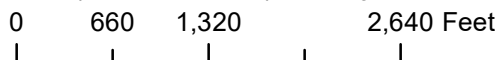

## Legend

IR POU Tax Lot DLC



EXPIRES: