



Looking Glass Organic Farms, LLC Claim of Beneficial Use (Cert. 38691 CN) Transfer T-13405

Township 28S, Range 7W, W.M.

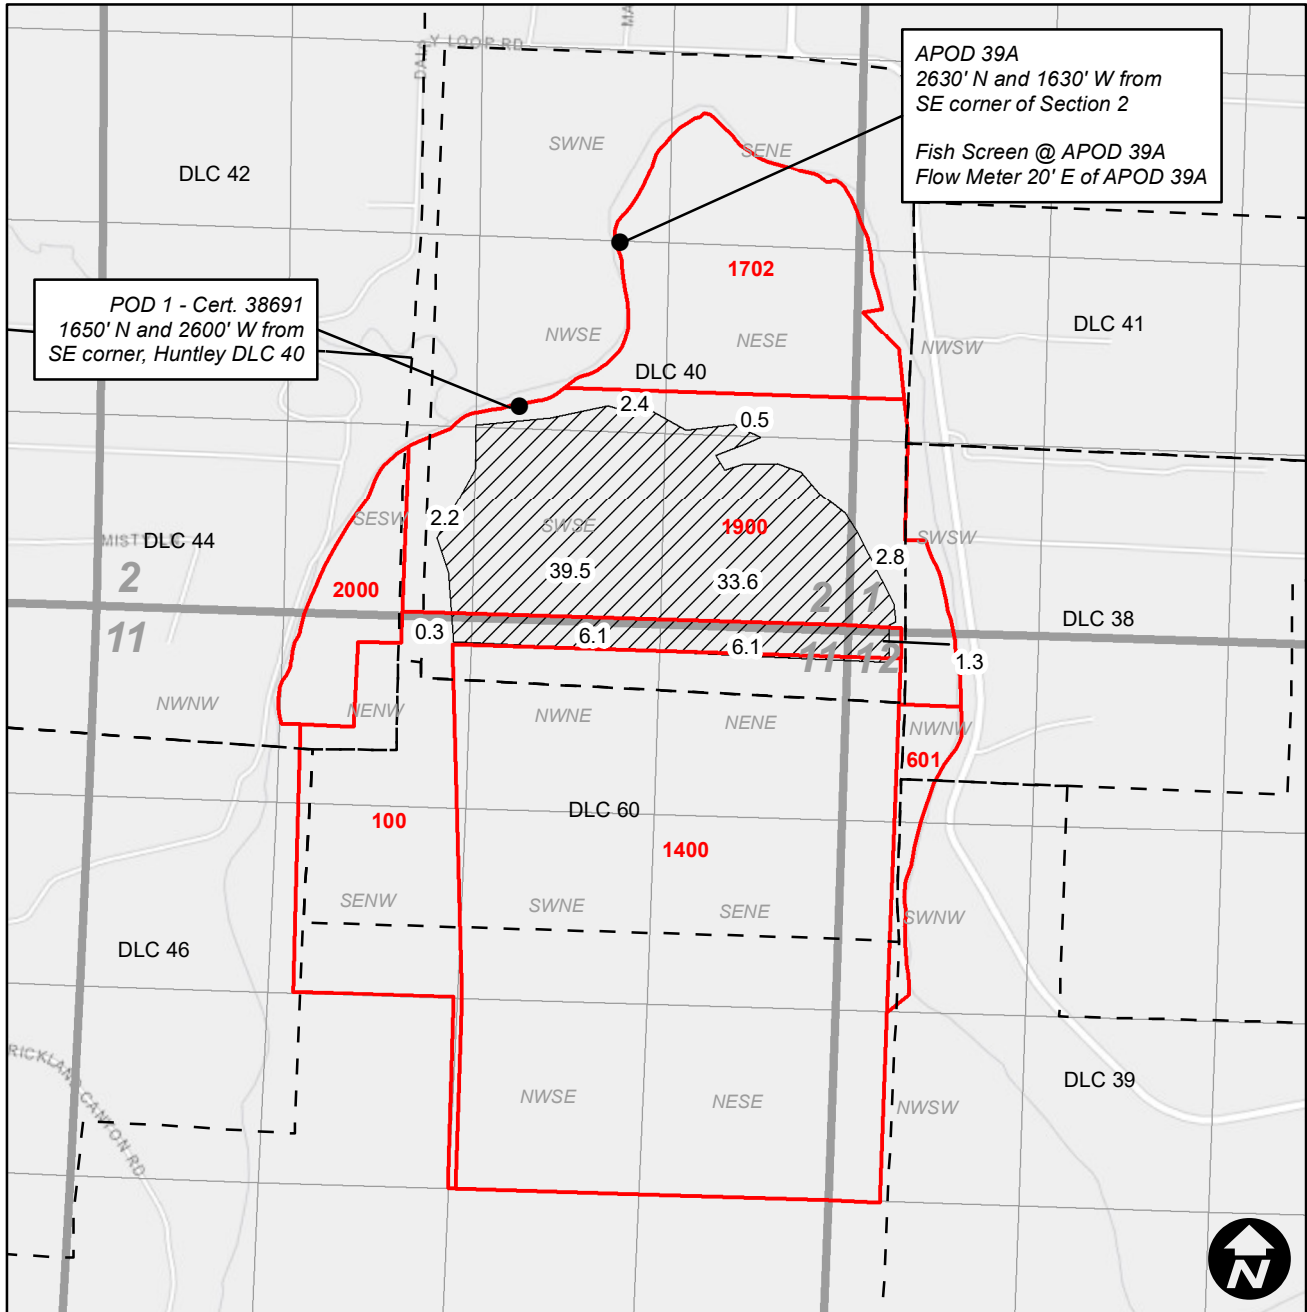

This map is not intended to provide legal dimensions or locations of property ownership lines.

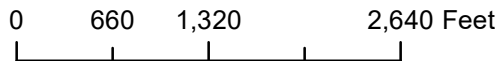

Legend

- IR POU
- Tax Lot
- DLC



EXPIRES: