

LEGEND

- TOWNSHIP LINE
- RANGE LINE
- SECTION LINE
- 1/4 1/4 LINE
- TAX LOT LINE
- MAINLINE PIPE
- ROAD
- $\frac{36}{1}6$ SECTION CORNER
- TL 0000 TAX LOT NUMBER
- ⊙ WELL
- ⊙ 35.0 SWSE IRRIGATED UNDER PERMIT G-15405

NOTES:

1. THIS MAP WAS PREPARED FROM FIELD MEASUREMENTS, NAIP 2022 AERIAL PHOTOGRAPHY, KLAMATH COUNTY TAX MAPS, AND OREGON GLO MAPS.
2. THE PURPOSE OF THIS MAP IS TO IDENTIFY THE LOCATION OF THE WATER RIGHT ONLY, AND IS NOT INTENDED TO PROVIDE DIMENSIONS OR LOCATION OF PROPERTY LINES.
3. DATE OF PRIORITY FOR THIS WATER RIGHT IS MAY 10, 2001.


WELL LOCATION:

WELL 1 (KLAM 52759): 1350' NORTH & 50' WEST FROM THE SOUTHEAST CORNER OF SECTION 36.

RECEIVED

APR 25 2023

OWRD

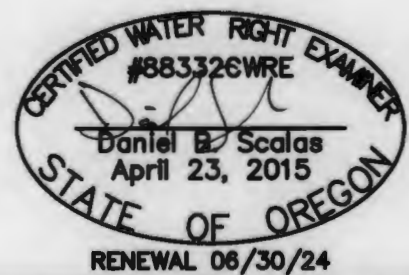

AL ADKINS ENGINEERING & SURVEYING
 o / 541.884.4666
 w / AdkinsEngineering.com

1435 ESPLANADE AVENUE, KLAMATH FALLS, OR 97601

SERVING S. OREGON & N. CALIFORNIA

ENGINEERING • SURVEYING • PLANNING • TESTING

CLAIM OF BENEFICIAL USE AND FINAL PROOF MAP

FOR
 CRISS DUNCAN
 T40S, R11E, SEC.6,WM; T41S, R11E, SEC.1,WM
 KLAMATH COUNTY, OREGON
 PERMIT G-15405
 APPLICATION G-15405