


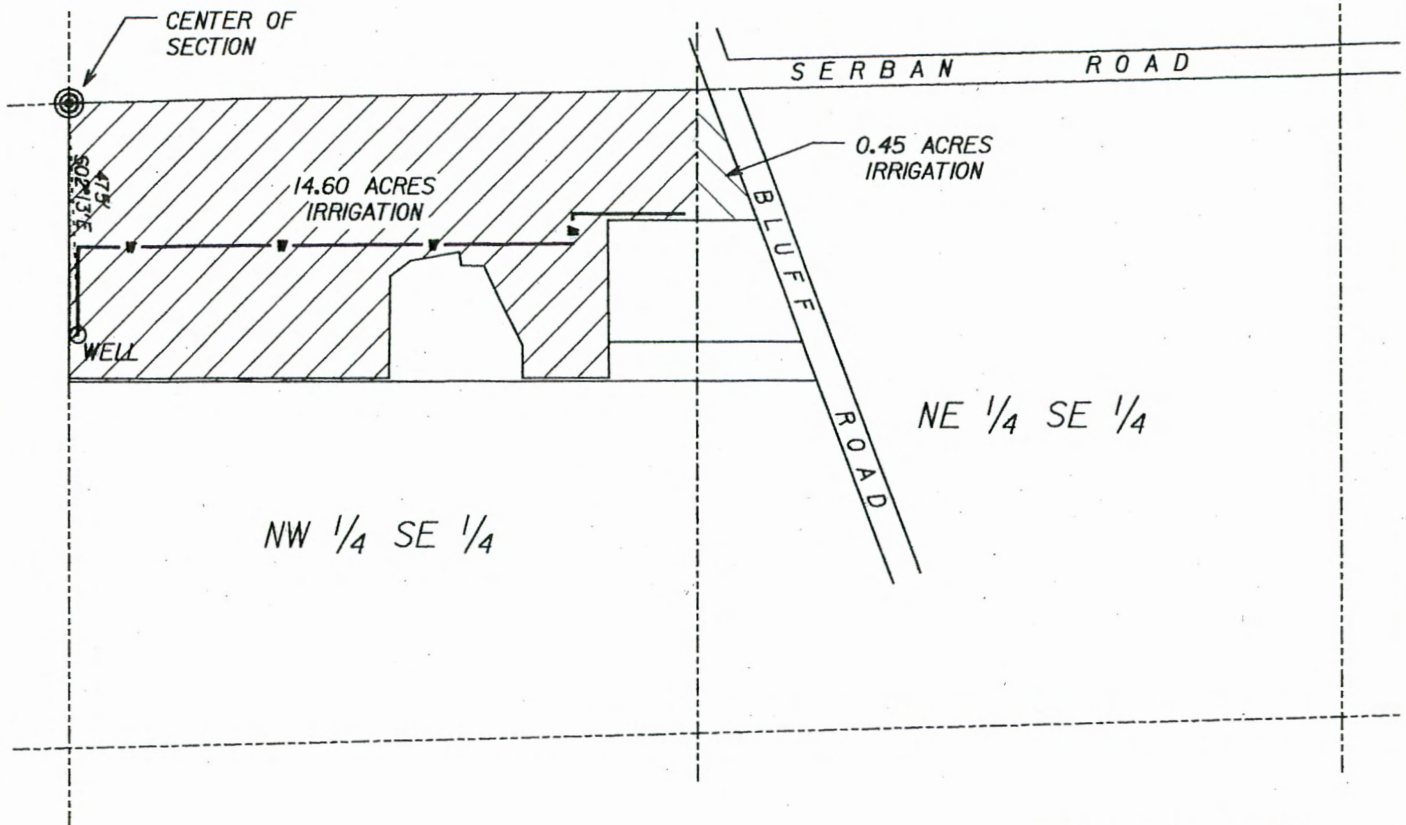

**RECEIVED**

OCT 01 1999


WATER RESOURCES DEPT.  
SALEM, OREGON

This drawing is an exhibit for a Final Proof Survey. It is not a Land Survey. Property lines and/or other lines of occupation shown hereon are not represented by the undersigned to meet accuracy standards of Land Surveys.



SCALE: 1" = 400'

**SECTION 2, T.2S., R.4E., W.M.  
CLACKAMAS COUNTY, OREGON**

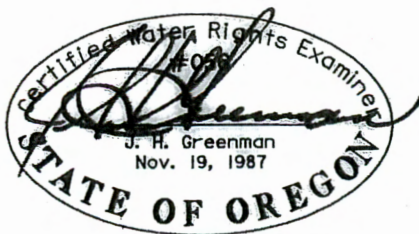

Application No. G-14082

Permit No. G-12894



**HANER, ROSS &  
SPORSEEN, INC.**  
15 S.E. 82ND DRIVE  
GLADSTONE, OREGON 97027

**MICHAEL & LISA REARDON**

**FINAL PROOF SURVEY**

809