



T.4S. R.1E. Sec. 6

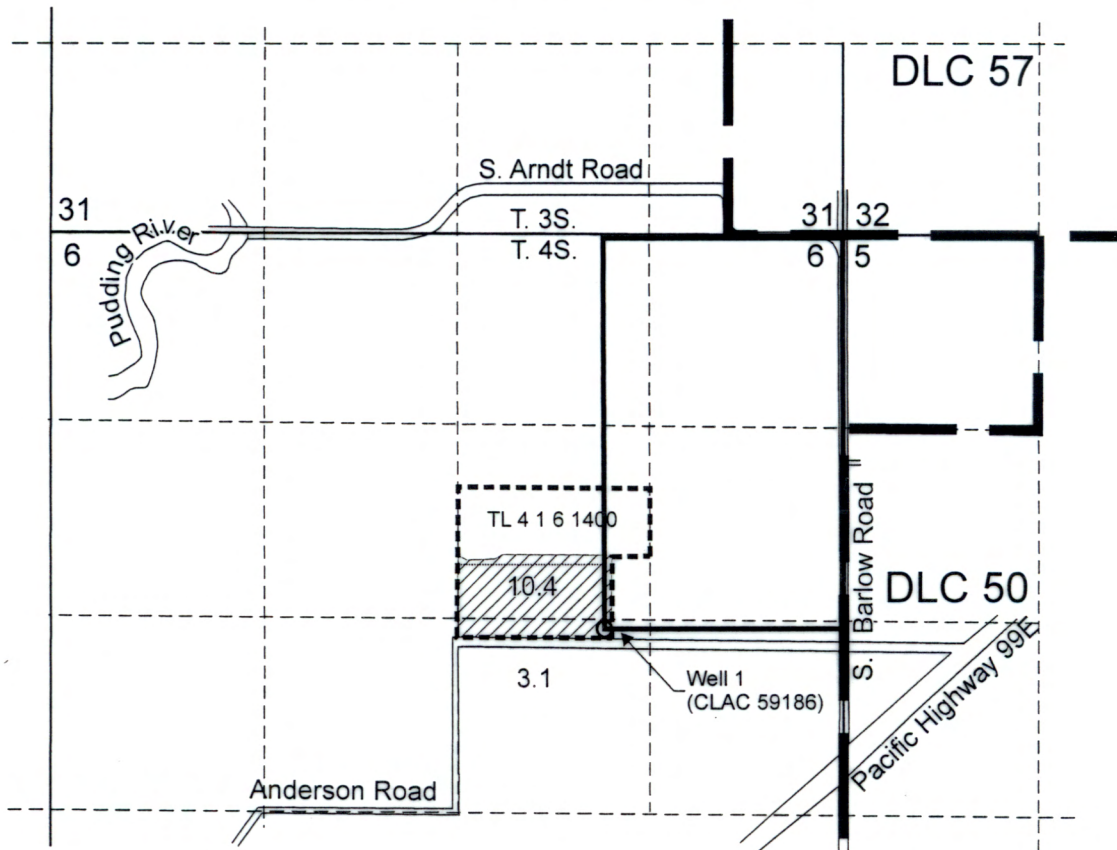


Well 1 (CLAC 59186/L65643) is located 2,695 feet south and 1,635 feet west from the NE Corner, Section 6.

 Area (13.5 Acres) irrigated under Application G-15756, Permit G-15433


----- Tax lot boundary

----- 5-inch Mainline

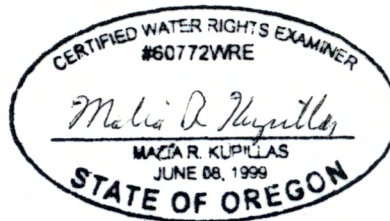

EXPIRATION DATE: 6/30/17

Scale: 1" = 1,320'

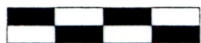

0 1,320 Feet

This map was prepared for the purpose of identifying the location of a water right only and is not intended to provide legal dimensions or location of property ownership lines.



Claim of Beneficial Use Map
Application G-15756, Permit G-15433

H & N Properties (Authorized Representative, Joe Dula)
T.4S. R.1E. Sec. 6

Pacific Hydro-Geology Inc.

12/15 - bgp