

CLAIM OF BENEFICIAL USE MAP


TO CHANGE PLACE OF USE AND
ADD POINTS OF APPROPRIATION
PER T-13756
FOR SUNNYSIDE DAIRY, LLC



TOWNSHIP 23 SOUTH, RANGE 33 EAST, SECTIONS 33 & 34, W.M.
TAX LOTS 5900 & 5901

RECEIVED


JUL 20 2023

OWPD

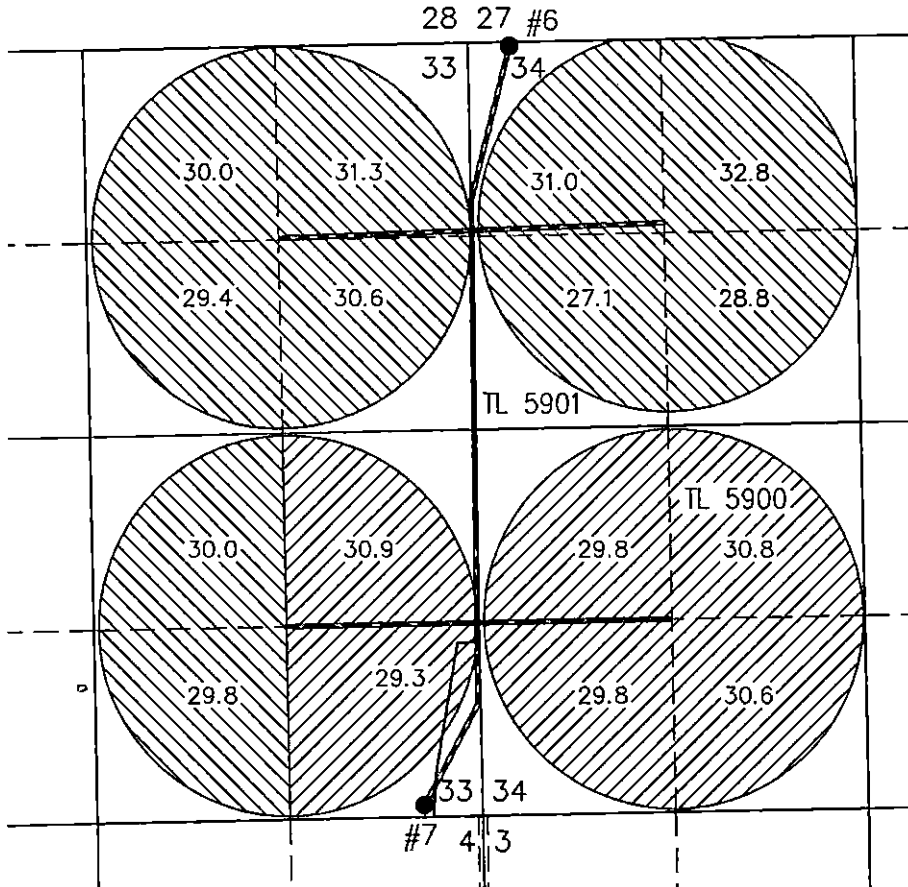

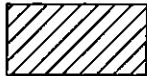
-  182.6 ACRES IR FROM T-13756 (C84202), AS SHOWN.
-  300.8 ACRES IR FROM T-13756 (C89855), AS SHOWN.

- **WELL 6 (HARN 52027)**
EXISTING WELL IN THE NW 1/4 NW 1/4 SECTION 34, T23S R33E, W.M. LOCATED 25 FEET SOUTH AND 285 FEET EAST FROM THE NW CORNER OF SECTION 34.
METER IS APPROXIMATELY 6.0 FEET SW'LY ALONG DELIVERY PIPE FROM WELL.
- **WELL 7 (HARN 621)**
EXISTING WELL IN THE SE 1/4 SE 1/4 SECTION 33, T23S R33E, W.M. LOCATED 80 FEET NORTH AND 400 FEET WEST FROM THE SE CORNER OF SECTION 33.
METER IS APPROXIMATELY 6.0 FEET N'LY ALONG DELIVERY PIPE FROM WELL.

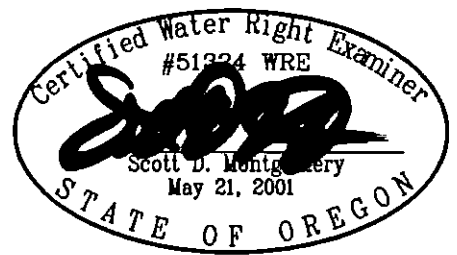

RENEWAL DATE: 12/31/2024


THIS MAP IS FOR THE PURPOSE OF LOCATING A WATER RIGHT ONLY AND HAS NO INTENT TO PROVIDE LEGAL DIMENSIONS OR THE LOCATION OF PROPERTY LINES

<p>PREPARED FOR:</p> <p>SUNNYSIDE DAIRY, LLC 4581 MAPLE GROVE RD SUNNYSIDE, WA 98944</p>	<p>PREPARED BY:</p>  <p>ALL POINTS ENGINEERING AND SURVEYING, INC. P.O. BOX 767 TERREBONNE, OR 97760 (541) 548-5833 www.APEandS.com</p>
--	--

Application for Permanent Transfer Sunnyside Dairy LLP TO LANDS

Certificate 84202 (Permit G-12027) and Certificate 89855 (Permit G-144)

Township 23 South, Range 33 East (W.M.)

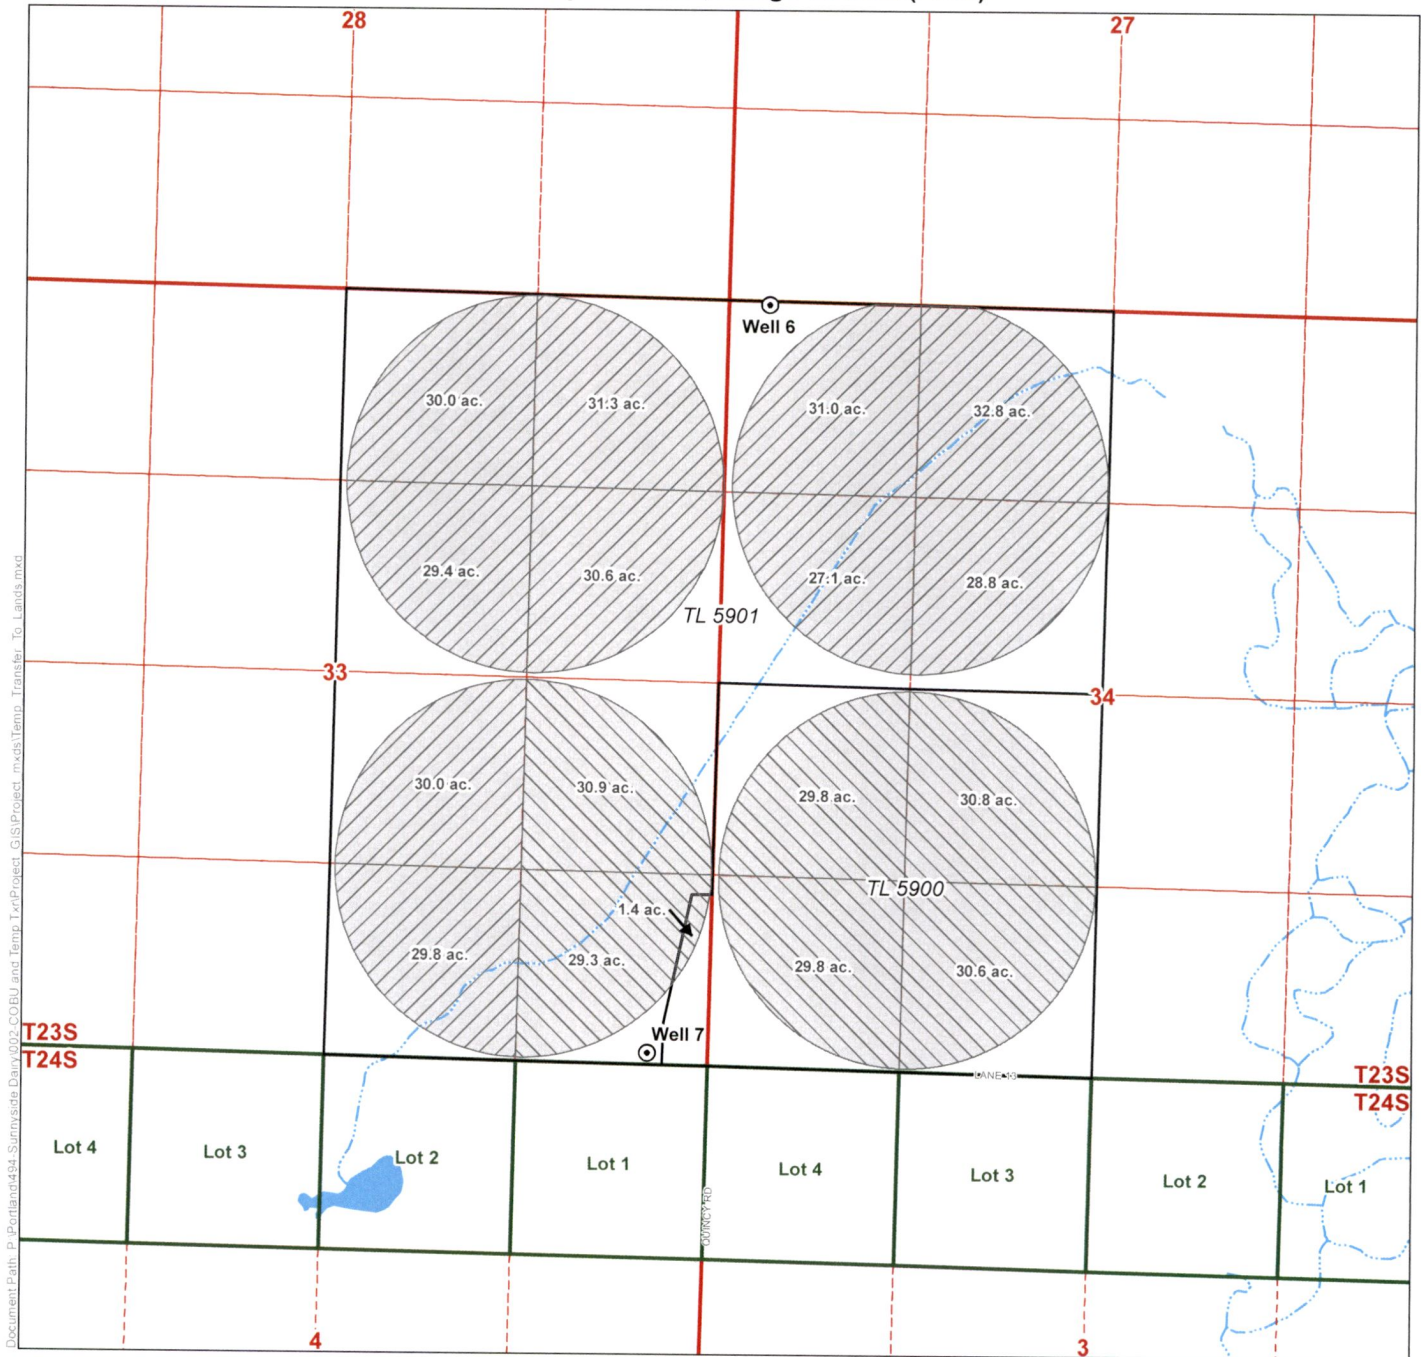

Document Path: P:\Portland\484-Sunnyside Dairy\03_COBU and Temp_Twp\Project_GIS\Project_mxd\Temp_Transfer_To_Lands.mxd

- LEGEND**
- ⊙ Point of Appropriation (POA)
 - Place of Use (POU)**
 - Certificate 84202
 - Certificate 89855
 - All Other Features**
 - Government Lots
 - Tax Lots
 - Waterbodies
 - Watercourses

POA LOCATION DESCRIPTIONS

Well 6
Located 25 feet South and 285 feet East from the NW corner of Section 34, Township 23 South, Range 33 East (W.M.)



Well 7
Located 80 feet North and 400 feet West from the SE corner of Section 33, Township 23 South, Range 33 East (W.M.)

Disclaimer

This map was prepared for the purpose of identifying the location of a water right only and it is not intended to provide legal dimensions or location of property ownership lines.

Map Notes

Date: February 20, 2015
Data Sources: OWRD, US BLM, USGS, ESRI
Prepared By: GeoEngineers, Inc.

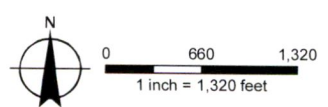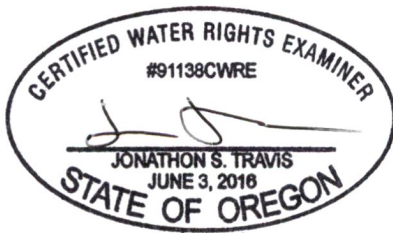

2/20/2027