


U-64

SECTION

TOWNSHIP 2N, RANGE 13E, W. M.

North

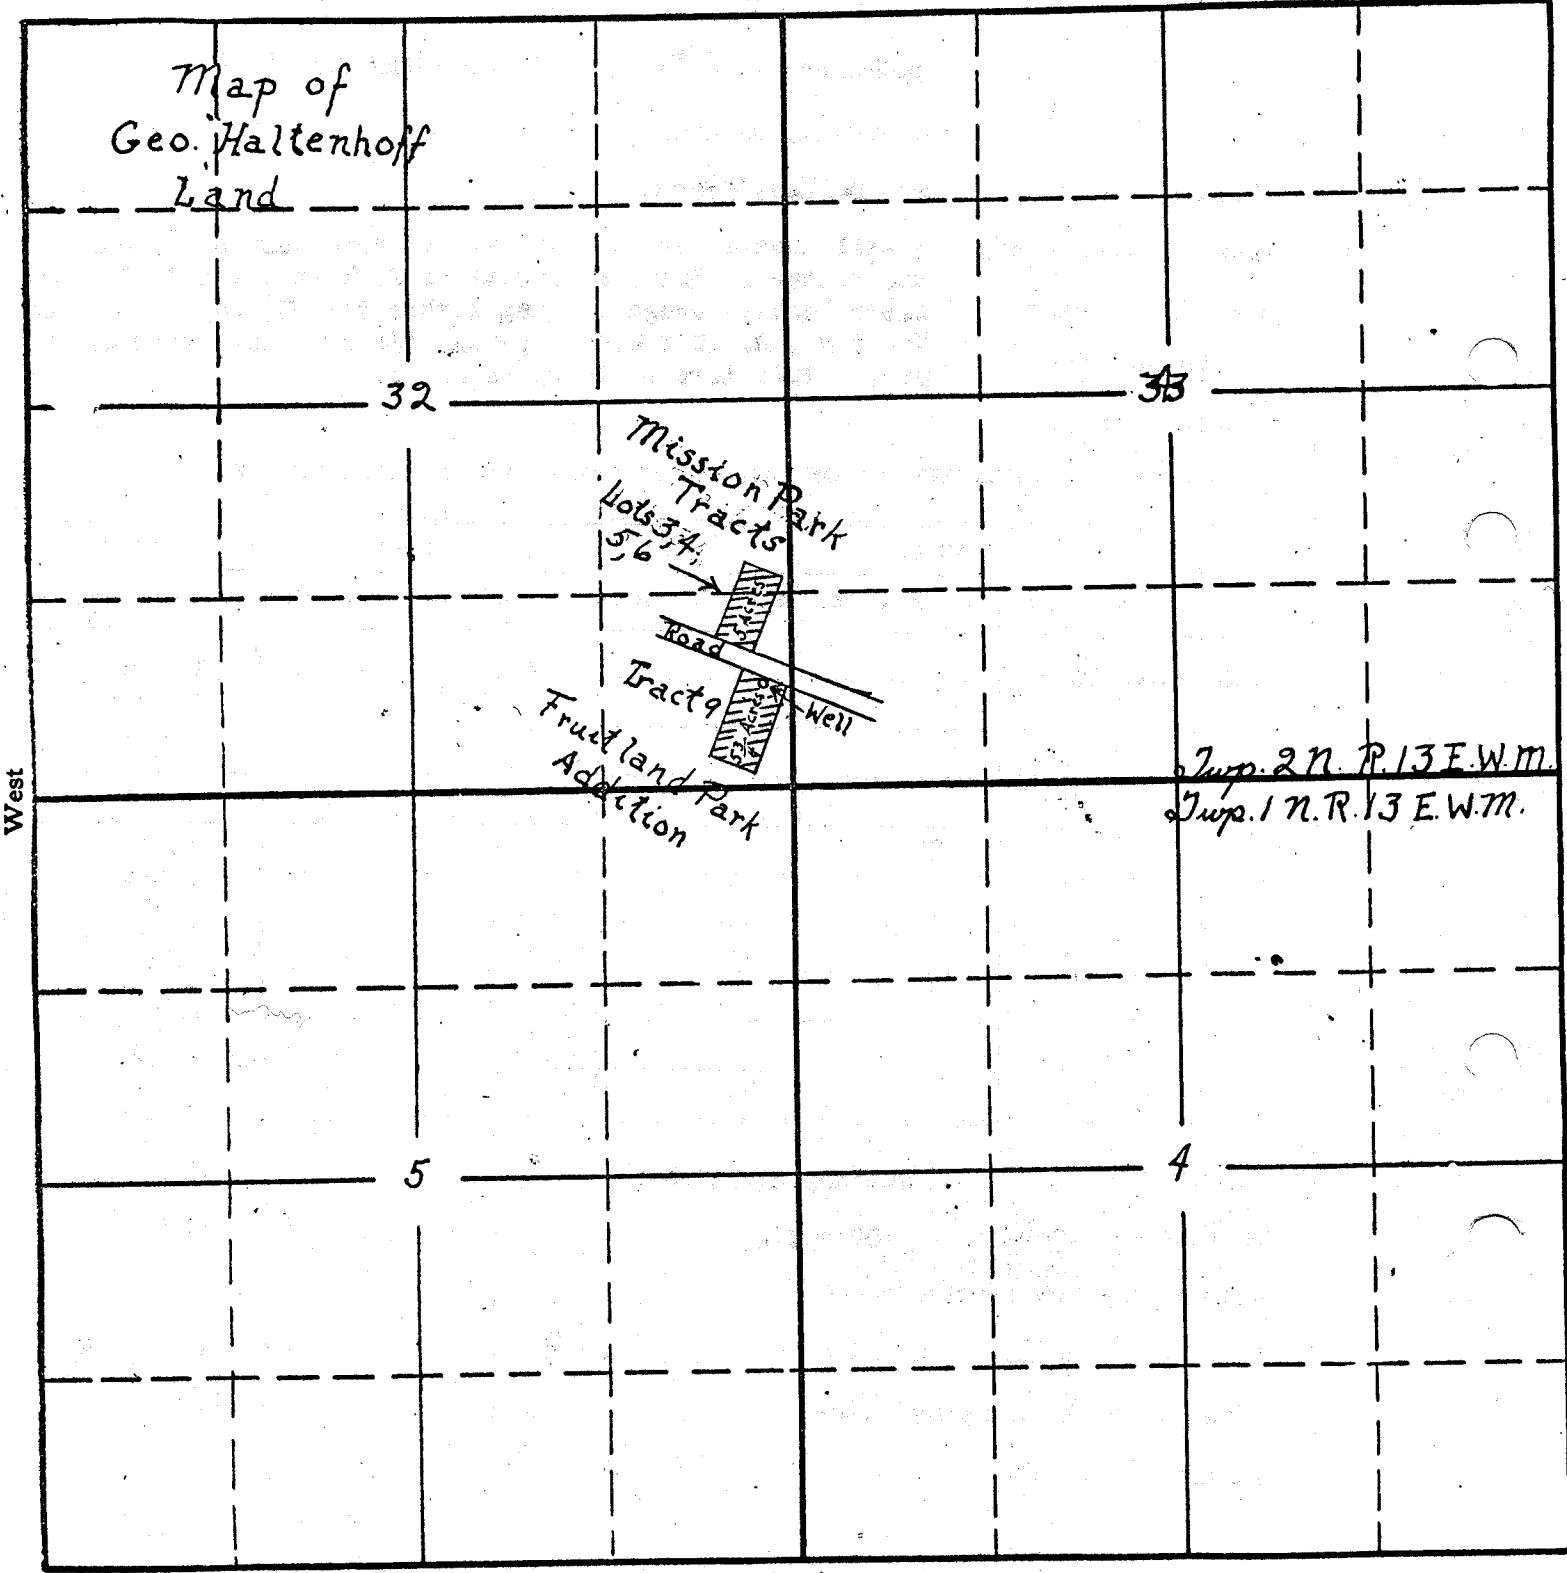

APPLICATION No. U-73
 PERMIT No. U-64