







# ACMPC Oregon 1, LLC: T-12630 Claim of Beneficial Use

Township 8S, Range 4W, W.M.

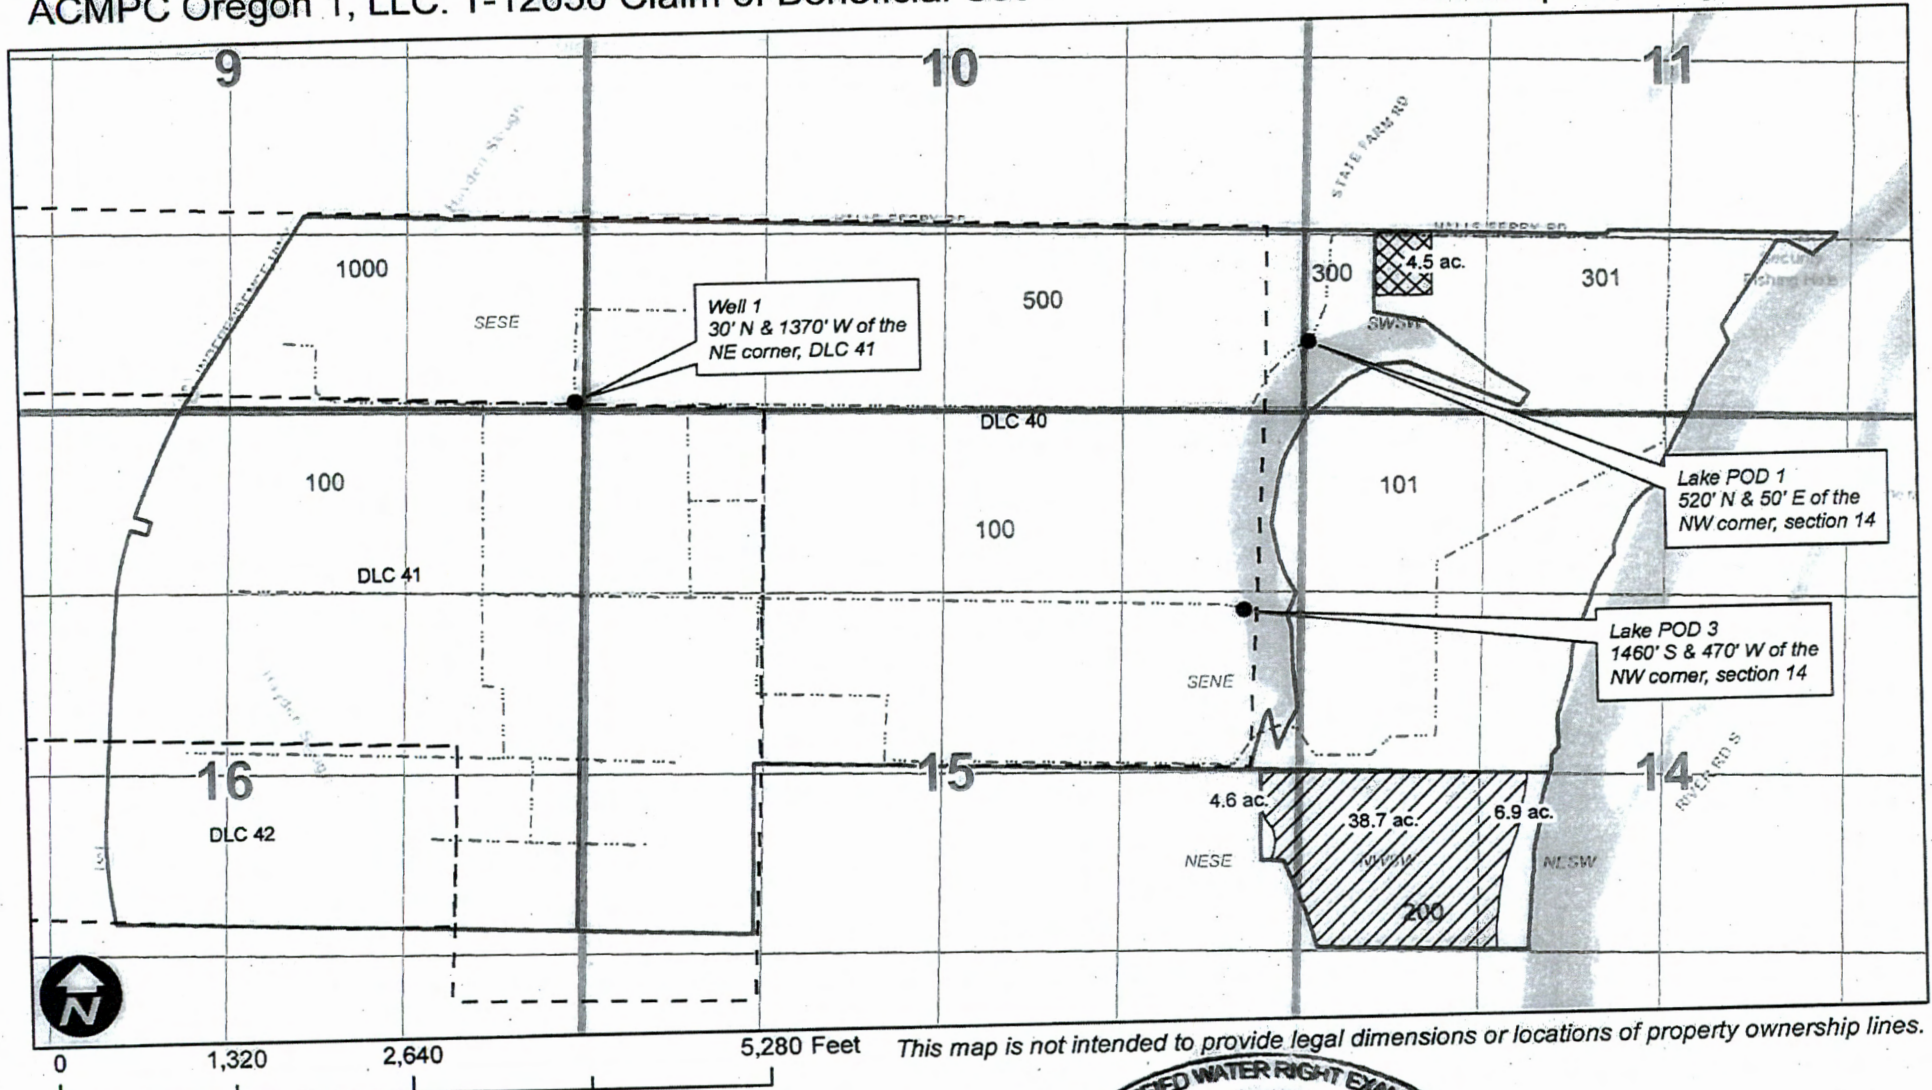

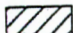This map is not intended to provide legal dimensions or locations of property ownership lines.

## Legend

-  T-12630 POU (Cert. 39081 POA change)
-  T-12630 POU (Cert. 81575 POD change)
-  Mainline
-  DLC
-  Tax Lot



EXPIRES: 12/31/2020

**WILL MCGILL SURVEYING LLC**  
15333 Pletzer Rd. SE  
Turner, OR 97392  
503-510-3026  
willmcgillsurveying@gmail.com