


THIS MAP WAS PREPARED FOR THE PURPOSE OF IDENTIFYING THE LOCATION OF THE WATER RIGHT AND IS NOT INTENDED TO PROVIDE LEGAL DIMENSIONS OR LOCATIONS OF PROPERTY OWNERSHIP LINES.

T12S; R9E; W.M.

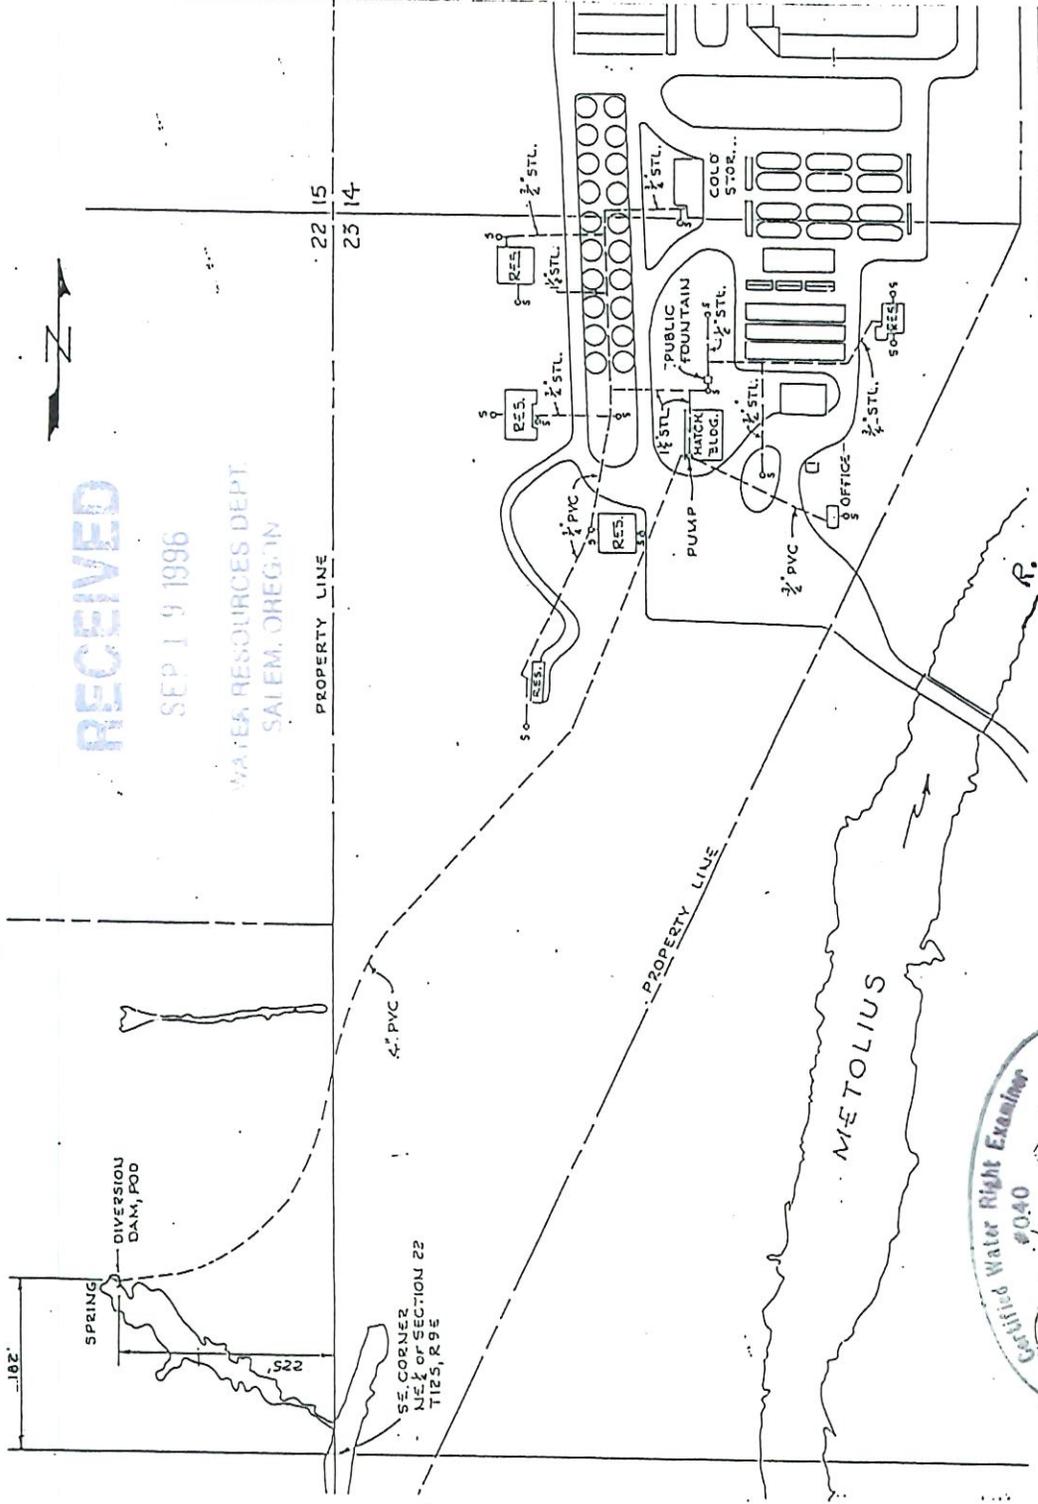

Certified Water Right Examiner
 #040
 Robert O. Dodge
 NOV 19, 1987
 STATE OF OREGON

SCALE: 1" = 200'

FINAL PROOF SURVEY
 UNDER
 APPLICATION NO. S-71381 PERMIT NO. 52466
 IN NAME OF
OREGON DEPARTMENT OF FISH AND WILDLIFE
 SURVEYED: 9/12/96 BY: DODGE

RECEIVED

SEP 19 1996

WATER RESOURCES DEPT
 SALEM, OREGON



22 15
 23 14

PROPERTY LINE

PROPERTY LINE

METOLIUS

