


CLAIM OF BENEFICIAL USE MAP
APPLICATION # R-73423 PERMIT # R-11841,
SECTION 15, TOWNSHIP 32 SOUTH, RANGE 15 WEST, W.M.
CURRY COUNTY, OREGON

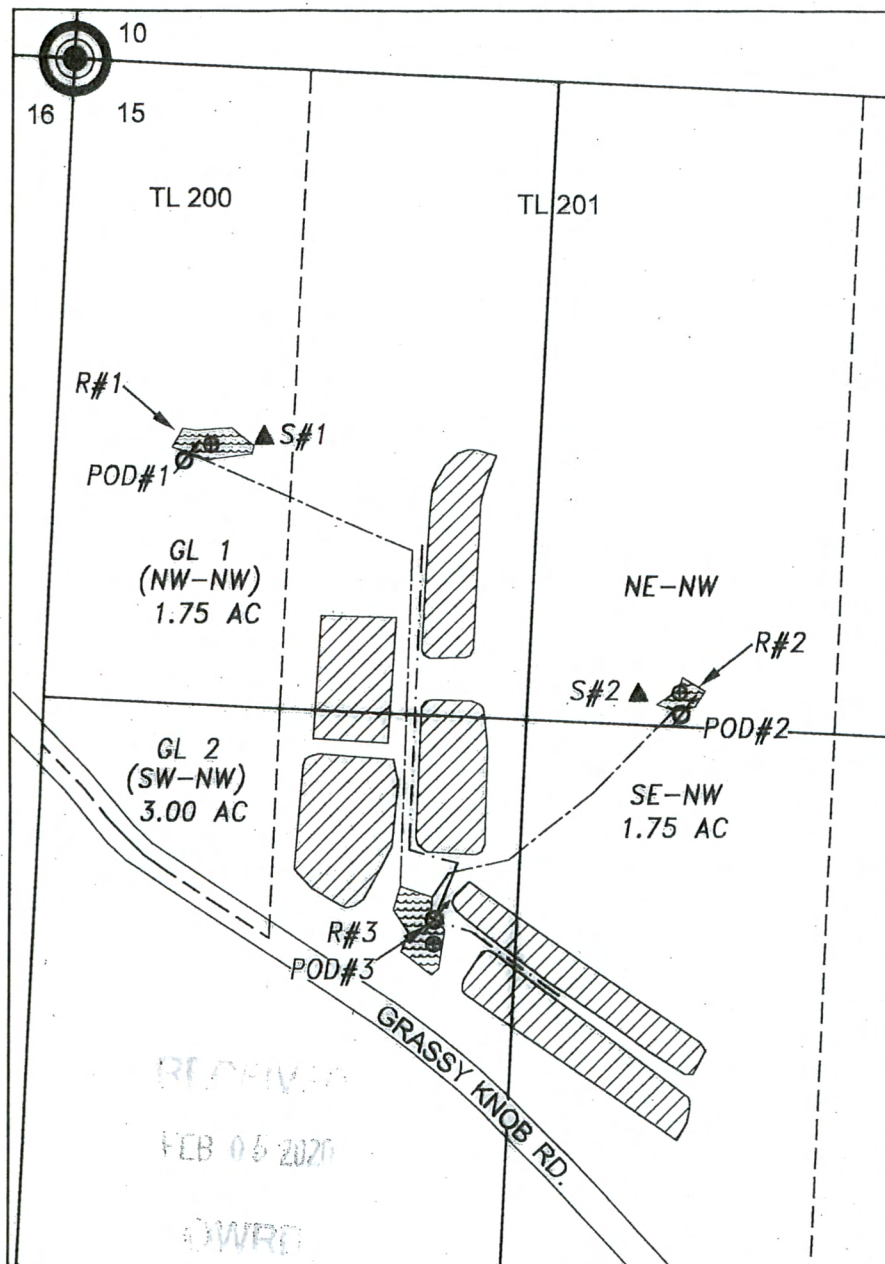

LEGEND

- POINT OF BEGINNING (POB)
NW COR. SEC.15 T32S. R15W. W.M
- POINT OF DIVERSION (POD)
- STAFF GAUGE
- SPRING
- CONVEYANCE LINE
- IRRIGATION MAINLINE
- TAXLOT BOUNDARIES
- PLACE OF USE
- RESERVOIR
- GL # GOVERNMENT LOT

SPRING	SOUTH	EAST
S#1	750'	400'
S#2	1280'	1180'

RESERVOIR	SOUTH	EAST
R#1	777'	212'
R#2	1312'	1313'
R#3	1775'	758'

POD	SOUTH	EAST
#1	808'	243'
#2	1336'	1247'
#3	1862'	727'

-DISTANCES FROM POB

DISCLAIMER: THIS MAP WAS PREPARED FOR THE PURPOSE OF IDENTIFYING THE LOCATION OF WATER RIGHT ONLY AND IS NOT INTENDED TO PROVIDE LEGAL DESCRIPTIONS OR LOCATIONS OF PROPERTY LINES.



NORTH

1"=400'



EXPIRES 06/30/2020

VCC

VAN CAMP CONSULTING

P.O. Box 995
Coos Bay, OR 97420
(541) 297-1880

vancampconsulting@gmail.com

Prepared For:
MICHAEL VON KORFF
P.O. BOX 222
SIXES, OR 97476

Project:
CLAIM OF BENEFICIAL
USE MAP
PERMIT # R-11841

Date:
12/04/2019