


T.7S. R.1E Sec. 16 & 21, W.M.

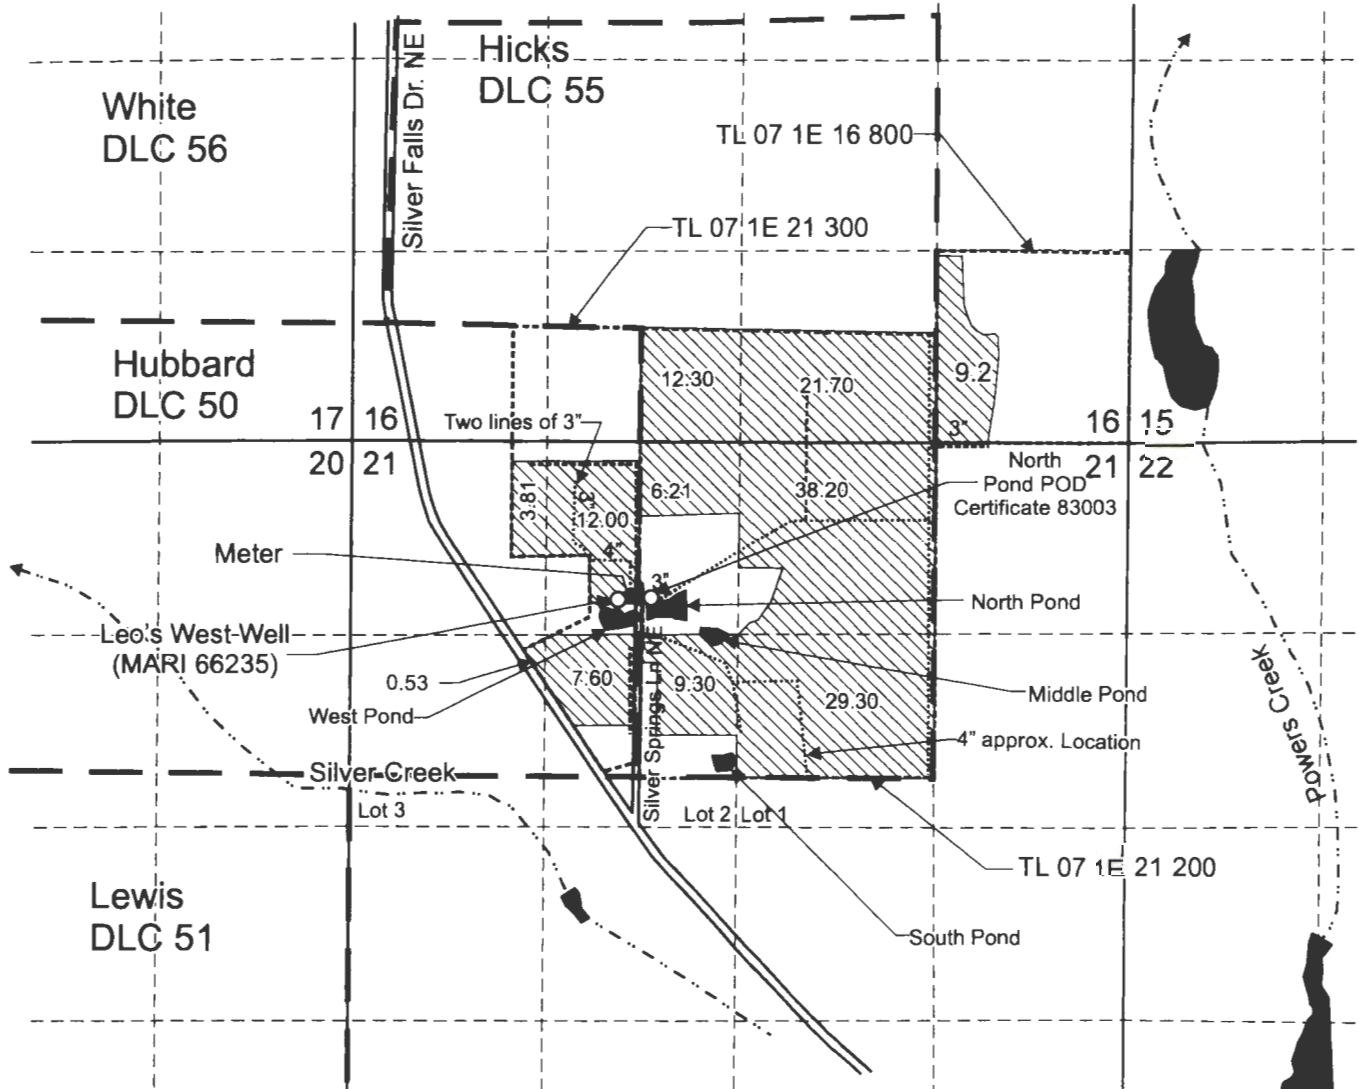

Leo's West Well (MARI 66235) is located 1,095 feet south and 1,815 feet east from the NW corner, Section 21.

Area (150.15 Acres) covered by nursery rights under Application G-18321, Permit G-17987.

----- Tax lot boundary

— • — Donation Land Claim boundary

..... Water main line



Scale: 1" = 1,320'



This map was prepared for the purpose of identifying the location of a water right only and is not intended to provide legal dimensions or location of property ownership lines.

Claim of Beneficial Use Map
Application G-18321, Permit G-17987

Pacific Hydro-Geology Inc.

05/2023

Jan H. Enterprises
T.7S. R.1E. Sec. 16 & 21, W.M.

RECEIVED
MAY 31 2023
OWRD