


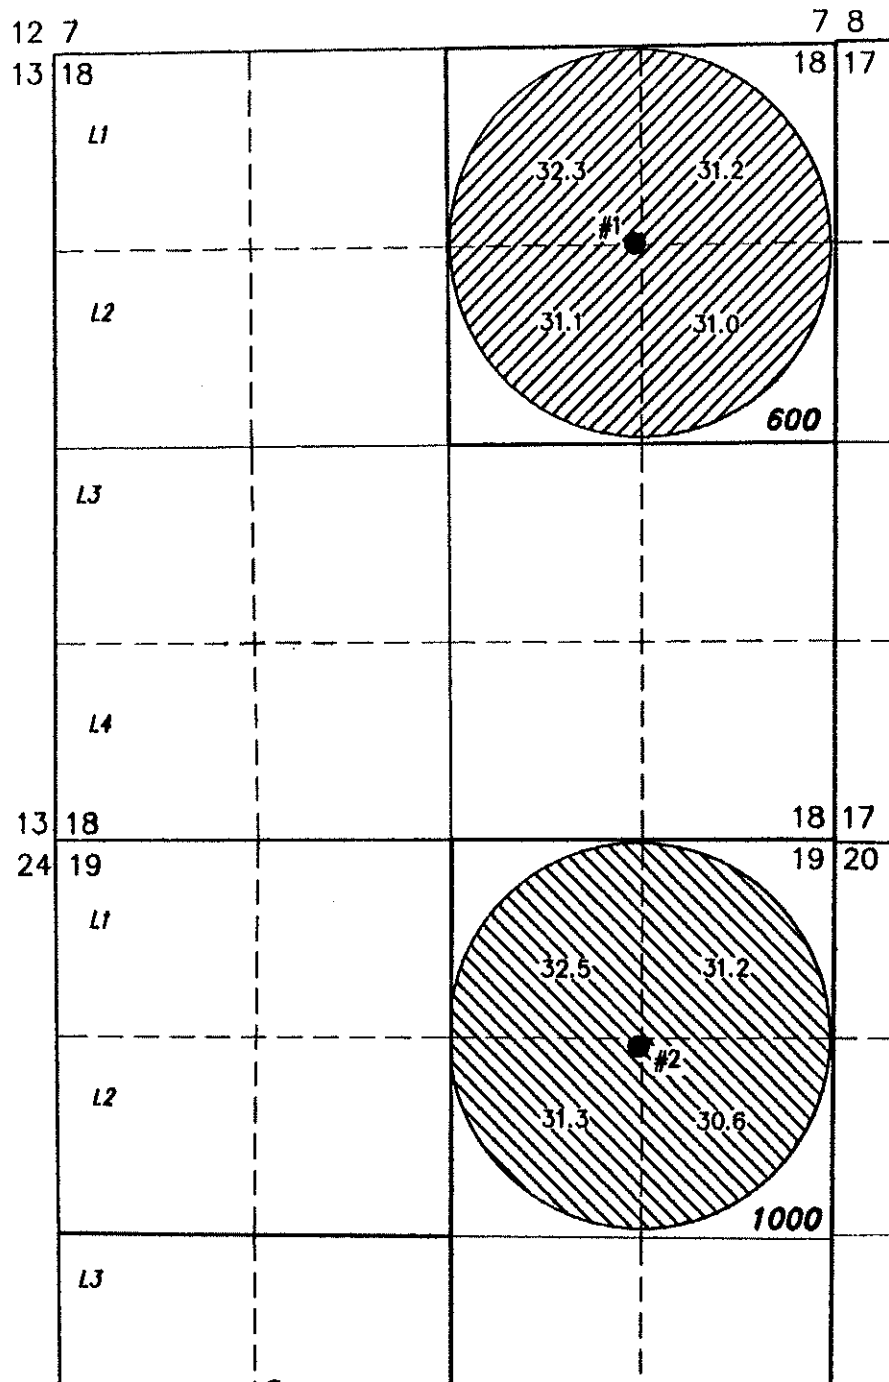

SCALE: 4 INCHES = 1 MILE



FINAL PROOF MAP

TO SHOW PLACES OF USE AND
POINTS OF APPROPRIATION
FOR APPLICATION G-16074
PEILA RANCH, INC.

SECTIONS 18 & 19, TOWNSHIP 27 SOUTH, RANGE 23 EAST, W.M.
TAX LOTS: 600 & 1000, LAKE COUNTY, OREGON

- #1 (LAKE 51219) PERMIT: G-15675
LOCATED IN THE SW 1/4 OF THE NE 1/4 & 1380' SOUTH
& 1390' WEST FROM THE NE CORNER OF SECTION 18.
METER #21487172 IS 1350' EAST FROM WELL.
- #2 (LAKE 51324) PERMIT: G-15675
LOCATED IN THE SW 1/4 OF THE NE 1/4 & 1420' SOUTH
& 1355' WEST FROM THE NE CORNER OF SECTION 19.
METER #85303375 IS 1350' EAST FROM WELL.

BURIED 8 INCH STEEL PIPE


-  125.6 ACRES PRIMARY IRRIGATION FROM
#1 (G-15675), AS SHOWN
-  125.6 ACRES PRIMARY IRRIGATION FROM
#2 (G-15675), AS SHOWN

COBU MAP # 823

RECEIVED BY OWRD

APR 11 2014

SALEM, OR

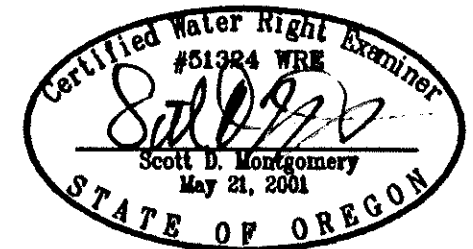

RENEWAL DATE: 12/31/2014

THIS MAP IS FOR THE PURPOSE OF LOCATING A WATER
RIGHT ONLY AND HAS NO INTENT TO PROVIDE LEGAL
DIMENSIONS OR THE LOCATION OF PROPERTY LINES

PREPARED FOR:
PEILA RANCH, INC.
P.O. BOX 697
BURNS, OR 97720

PREPARED BY:



ALL POINTS ENGINEERING AND SURVEYING, INC.
P.O. BOX 787 (CRR) TERREBONNE, OR 97760
(541) 548-5833
www.APEandS.com