
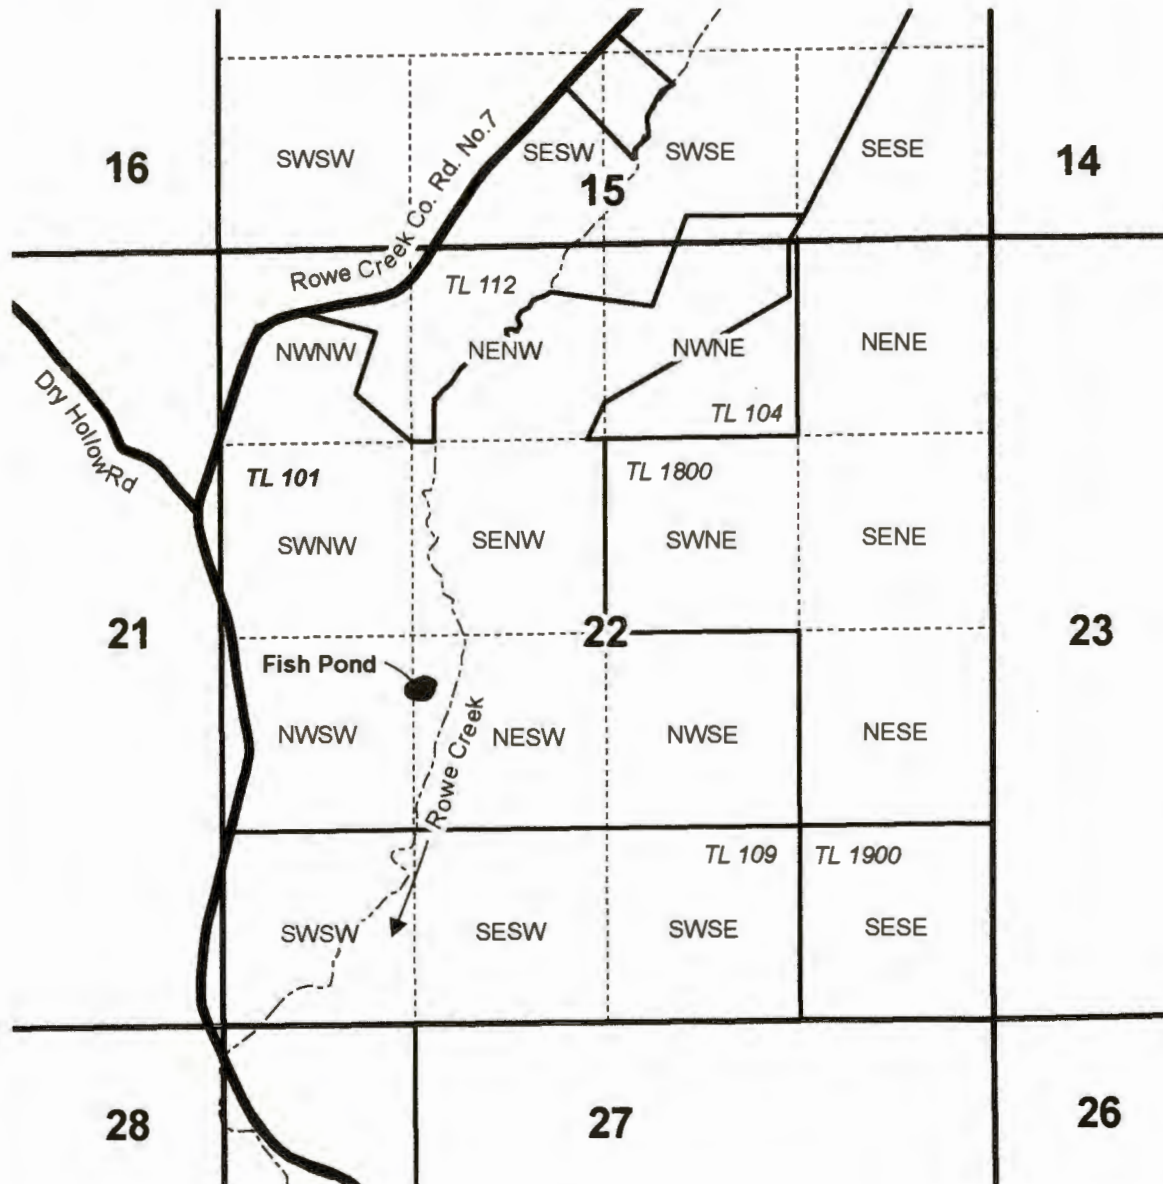


**T9S R21E, WM
WHEELER COUNTY, OR**

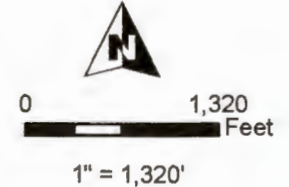

- Creek
- Place of Use (Multiple Purpose)
- Section
- Quarter Quarter
- Tax Lot

Fish Pond at Big Bottom Ranch Location (Center):
350' S, 1370' E of W 1/4 Cor Sec 22

RECEIVED

JUL 27 2023

OWRD



**CLAIM OF BENEFICIAL USE MAP
CONTENTION RANCH, LLC / BIG BOTTOM RANCH**

Date: 6/26/2023 Ap R-88146 Permit R-15160

This map is not intended
to provide legal dimensions
or locations of property
ownership lines.

WATER RIGHT SERVICES, LLC

PO BOX 1830, BEND, OR 97709

WWW.OREGONWATER.US CCB # 197121

johnshort@usa.com

541-389-2837