

CLAIM OF BENEFICIAL USE MAP

LOCATED IN THE SW 1/4 OF THE NW 1/4
OF SECTION 22, TOWNSHIP 23 SOUTH, RANGE 12 WEST, W.M.
COOS COUNTY, OREGON
APPLICATION S-81170, PERMIT S-53172


DATE: MARCH 5, 2013

SURVEY METHOD:

THE P.O.D. WAS TIED BY CONVENTIONAL TOTAL STATION TRAVERSE TO PROPERTY CORNERS SHOWN PER COOS COUNTY SURVEY 3B29. THE POSITION OF THE WEST 1/4 CORNER OF SECTION 22 WAS CALCULATED BASED ON RECORD INFORMATION PER SAID CS3B22 AND CS3B29.

NOTE:

THE POINT OF DIVERSION IS LOCATED 678 FEET EAST AND 509 FEET NORTH OF THE WEST 1/4 CORNER OF SECTION 22, T.23S., R.12W., W.M.

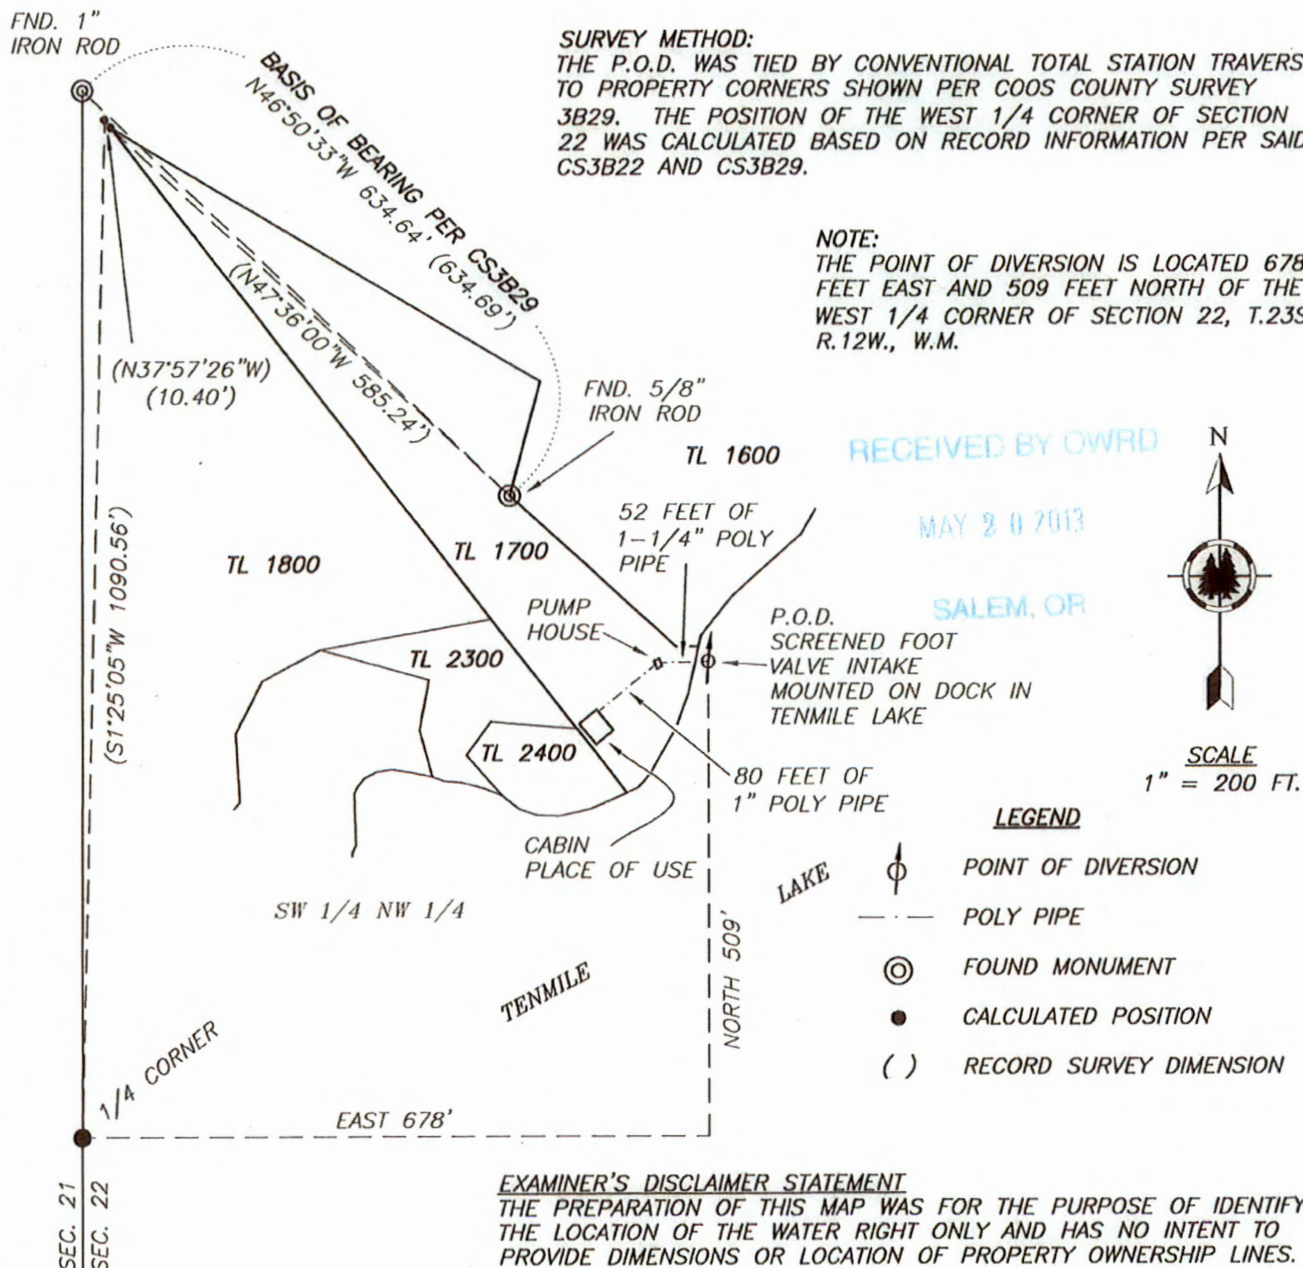

EXAMINER'S DISCLAIMER STATEMENT

THE PREPARATION OF THIS MAP WAS FOR THE PURPOSE OF IDENTIFYING THE LOCATION OF THE WATER RIGHT ONLY AND HAS NO INTENT TO PROVIDE DIMENSIONS OR LOCATION OF PROPERTY OWNERSHIP LINES.



Stuntzner
Engineering
& Forestry, LLC

705 S. 4TH ST.
P.O. BOX 118
COOS BAY, OREGON 97420

PHONE: (541) 267-2872
FAX: (541) 267-0588
www.stuntzner.com

Engineering - Land Surveying - Forestry - Land Planning - Water Rights

JOB #: 113-039
DATE: April 2013
DRAWN BY: CMW
CHECKED BY: CMW

PREPARED
FOR:

Donald W. Thompson, Inc.
North Bend, OR

FILE NAME: 113-039 THOMPSON COBU.dwg

SHEET 1 OF 1