

TAX LOT 600  
T 35 R 45E  
158.4 AC

T 25  
T 35

CENTER PIVOT  
10" PIPE TO PUMP

PUMP  
SILVER LAKE DITCH

INTAKE SCREEN

METER IS LOCATED  
ON PUMP DISCHARGE  
12" PIPE BETWEEN  
SCREEN & PUMP



1" = 1320'

T 35, R 45E  
SEC 3

3

RECEIVED

JAN 06 2021

OWRD

RECEIVED

FEB 04 2021

OWRD

LEGEND



LAND TO RECEIVE SUPPLEMENTAL IRRIGATION  
FROM WALLONA LAKE RESERVOIR UNDER PERMIT S-54875  
EXISTING PRIMARY RIGHT CERT 55334, PRIORITY DATE 4/28/1976




EXISTING WATER RIGHTS, PRIMARY WALLONA LAKE DECREE  
SUPPLEMENTAL R-347 WALLONA LAKE RESERVOIR

POINT OF DIVERSION IS WALLONA LAKE DAM LOCATED 870' SOUTH  
AND 1100' WEST FROM THE NE CORNER OF NENW SEC 5, T 35, R 45E

RECEIVED

FEB 26 2021

OWRD

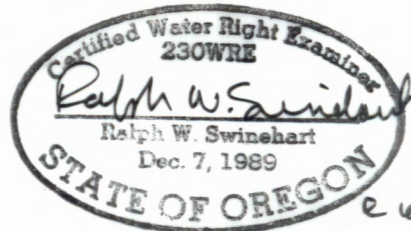

R 4/30/22

THIS MAP IS PREPARED FOR WATER RIGHT  
PURPOSES ONLY AND SHOULD NOT BE  
USED FOR PROPERTY LOCATION PURPOSES

PERMIT S-54875 SUPPLEMENTAL IRRIG  
SEC 3 T 35, R 45E, W.M.  
WALLONA COUNTY

FINAL PROOF MAP FOR:  
DAN & LORI BUTTERFIELD  
61901 PRAIRIE CK RD  
JOSEPH, OREGON 97846

PREPARED BY WALLONA Mtn ENGINEERING  
ENTERPRISE, OREGON 9/1/2020