


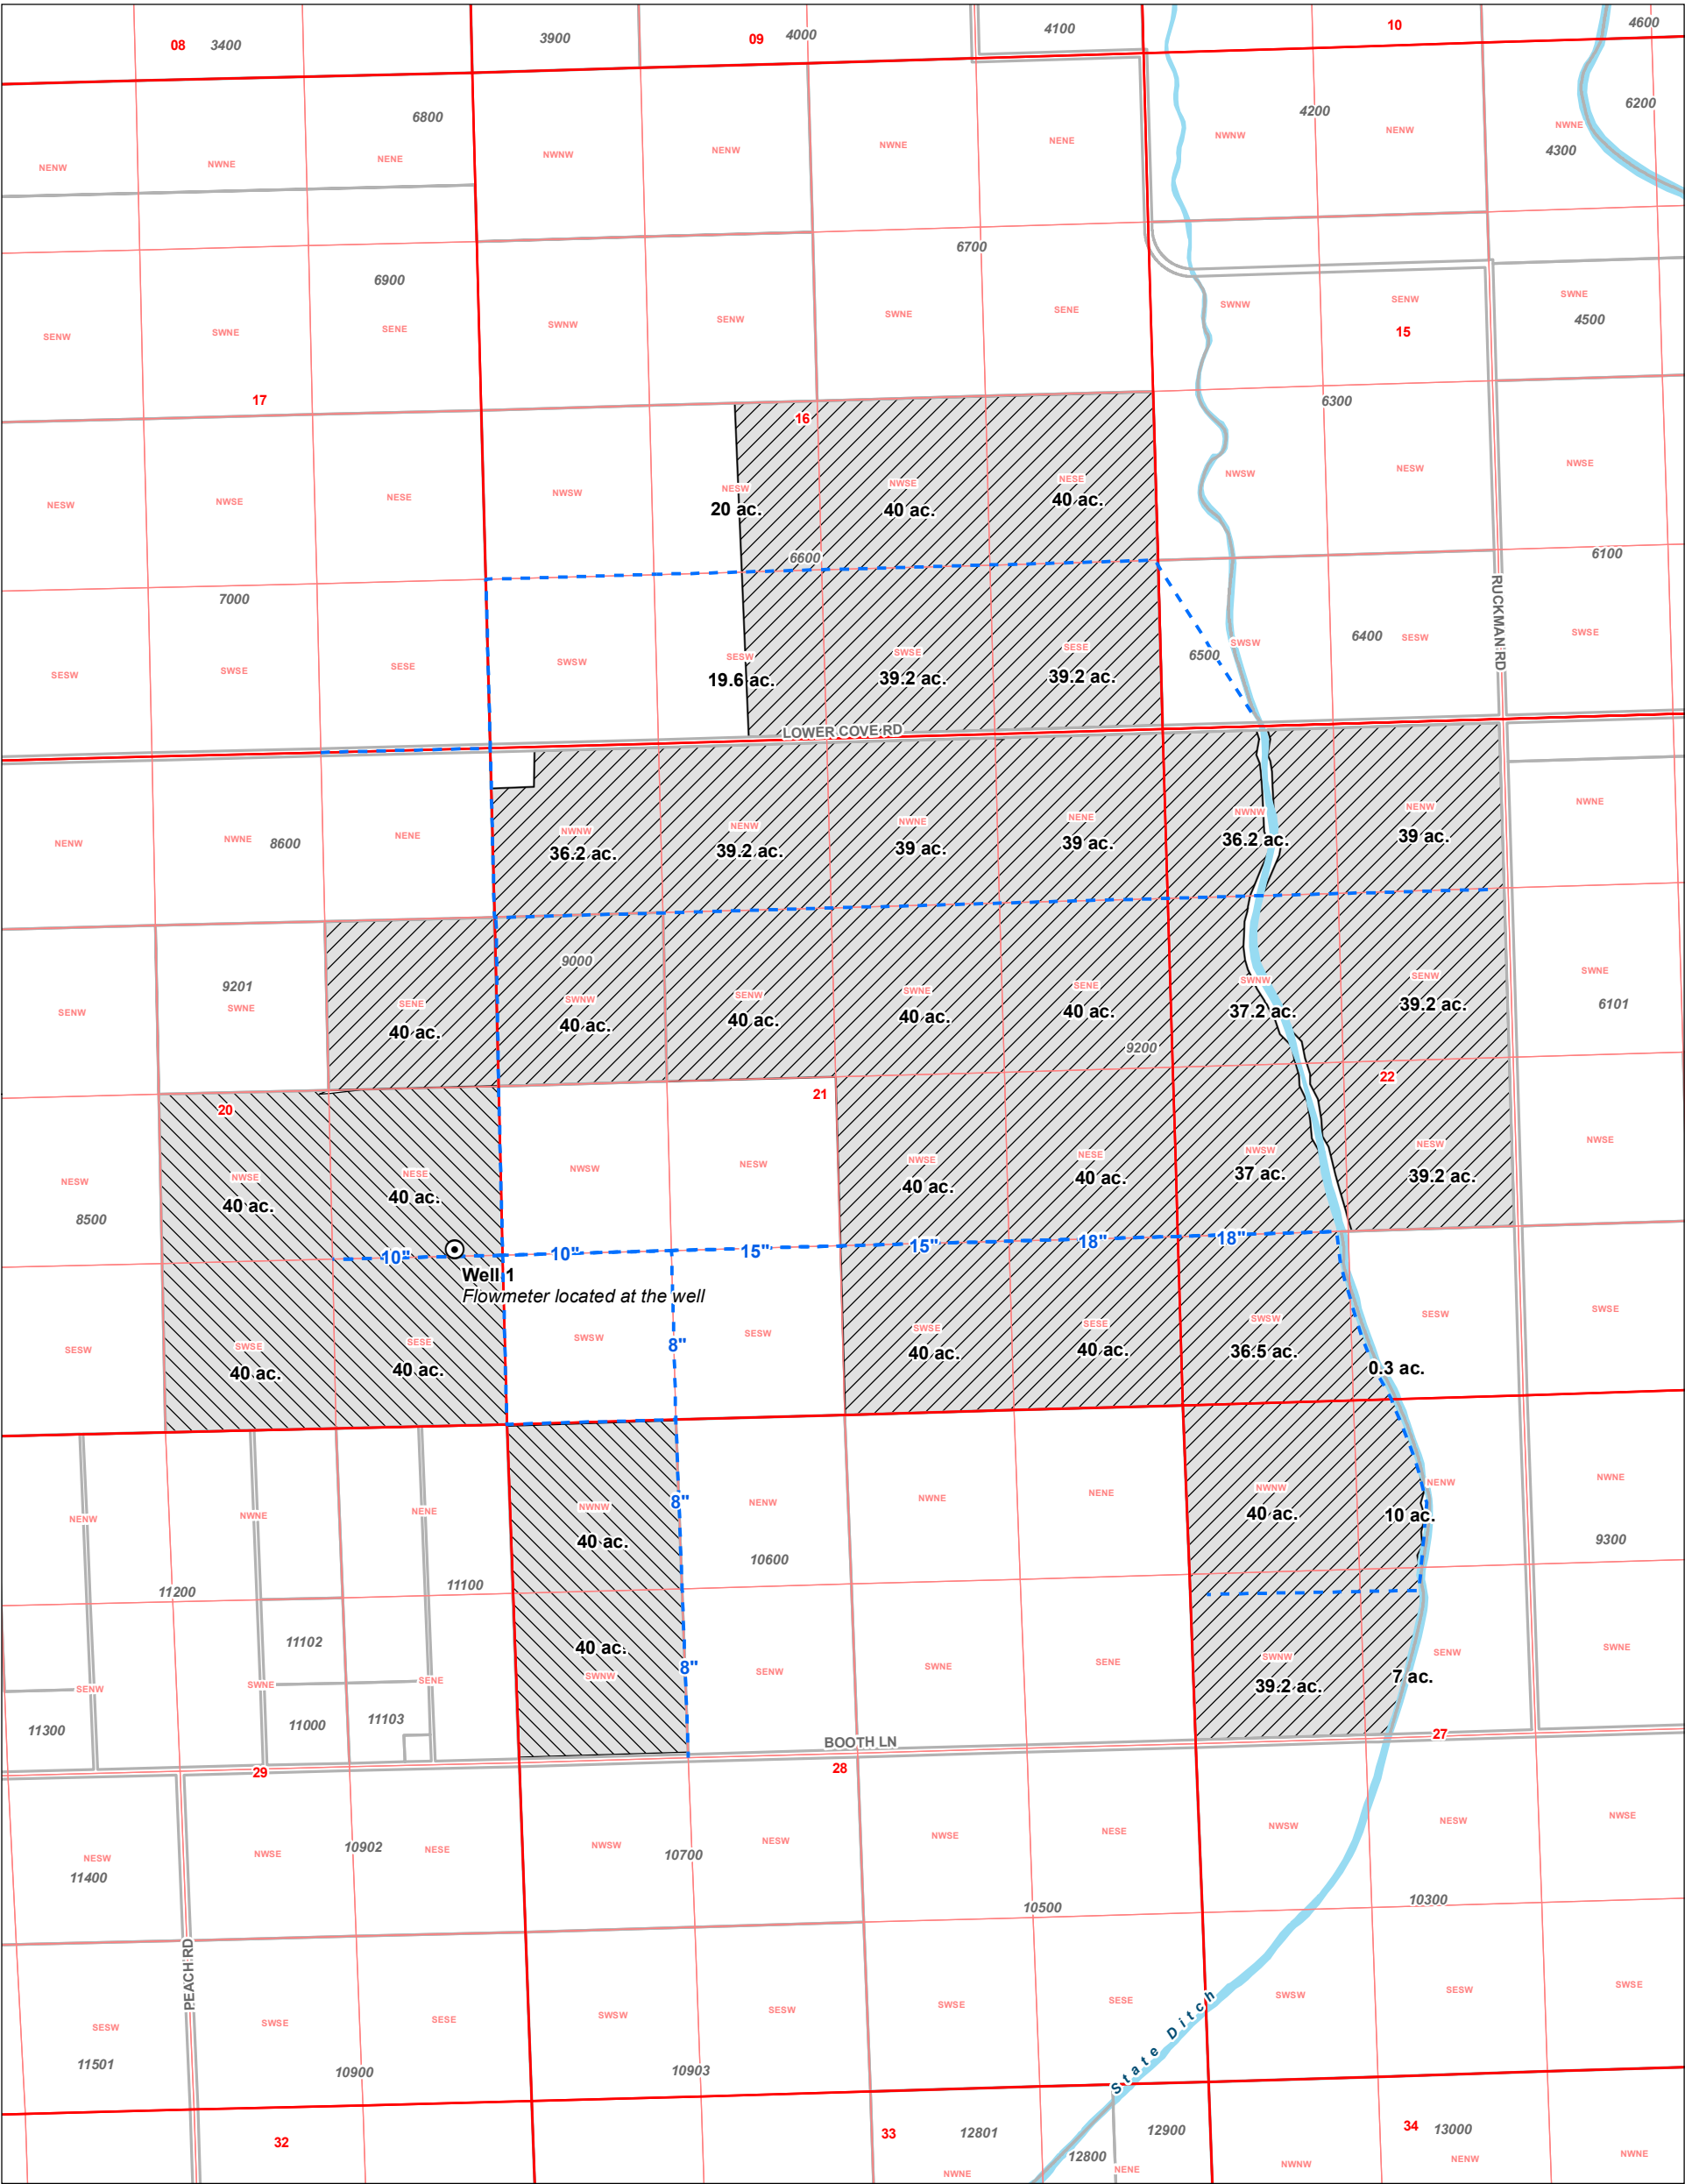


LEGEND

- Point of Appropriation (POA)
- Mainline
- Primary Irrigation
- Supplimental Irrigation
- Tax Lot
- Watercourse
- Waterbody

LOCATION DESCRIPTION

Well 1
Located 1362 feet north and 400 feet west from the SE corner, Section 20, Township 2 South, Range 39 East (W.M.)

CERTIFIED WATER RIGHTS EXAMINER STAMP

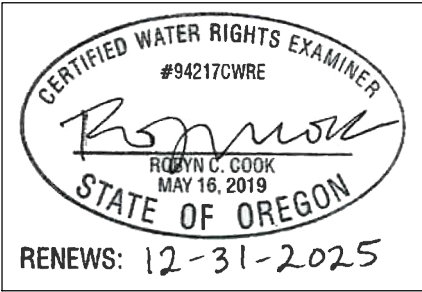

Claim of Beneficial Use
In the name of Green LaGrande III, LLC
Place of Use/Point of Appropriation Map
Permit G-15709, Application G-16169
Township 2 South, Range 39 East (W.M.)
Union County

DISCLAIMER
This map was prepared for the purpose of identifying the location of a water right only and it is not intended to provide legal dimensions or location of property ownership lines.
Date: February 16, 2024
Data Sources: BLM, ESRI, OWRD, USGS

