


RECEIVED

OCT 01 2004

WATER RESOURCES DEPT
SALEM, OREGON


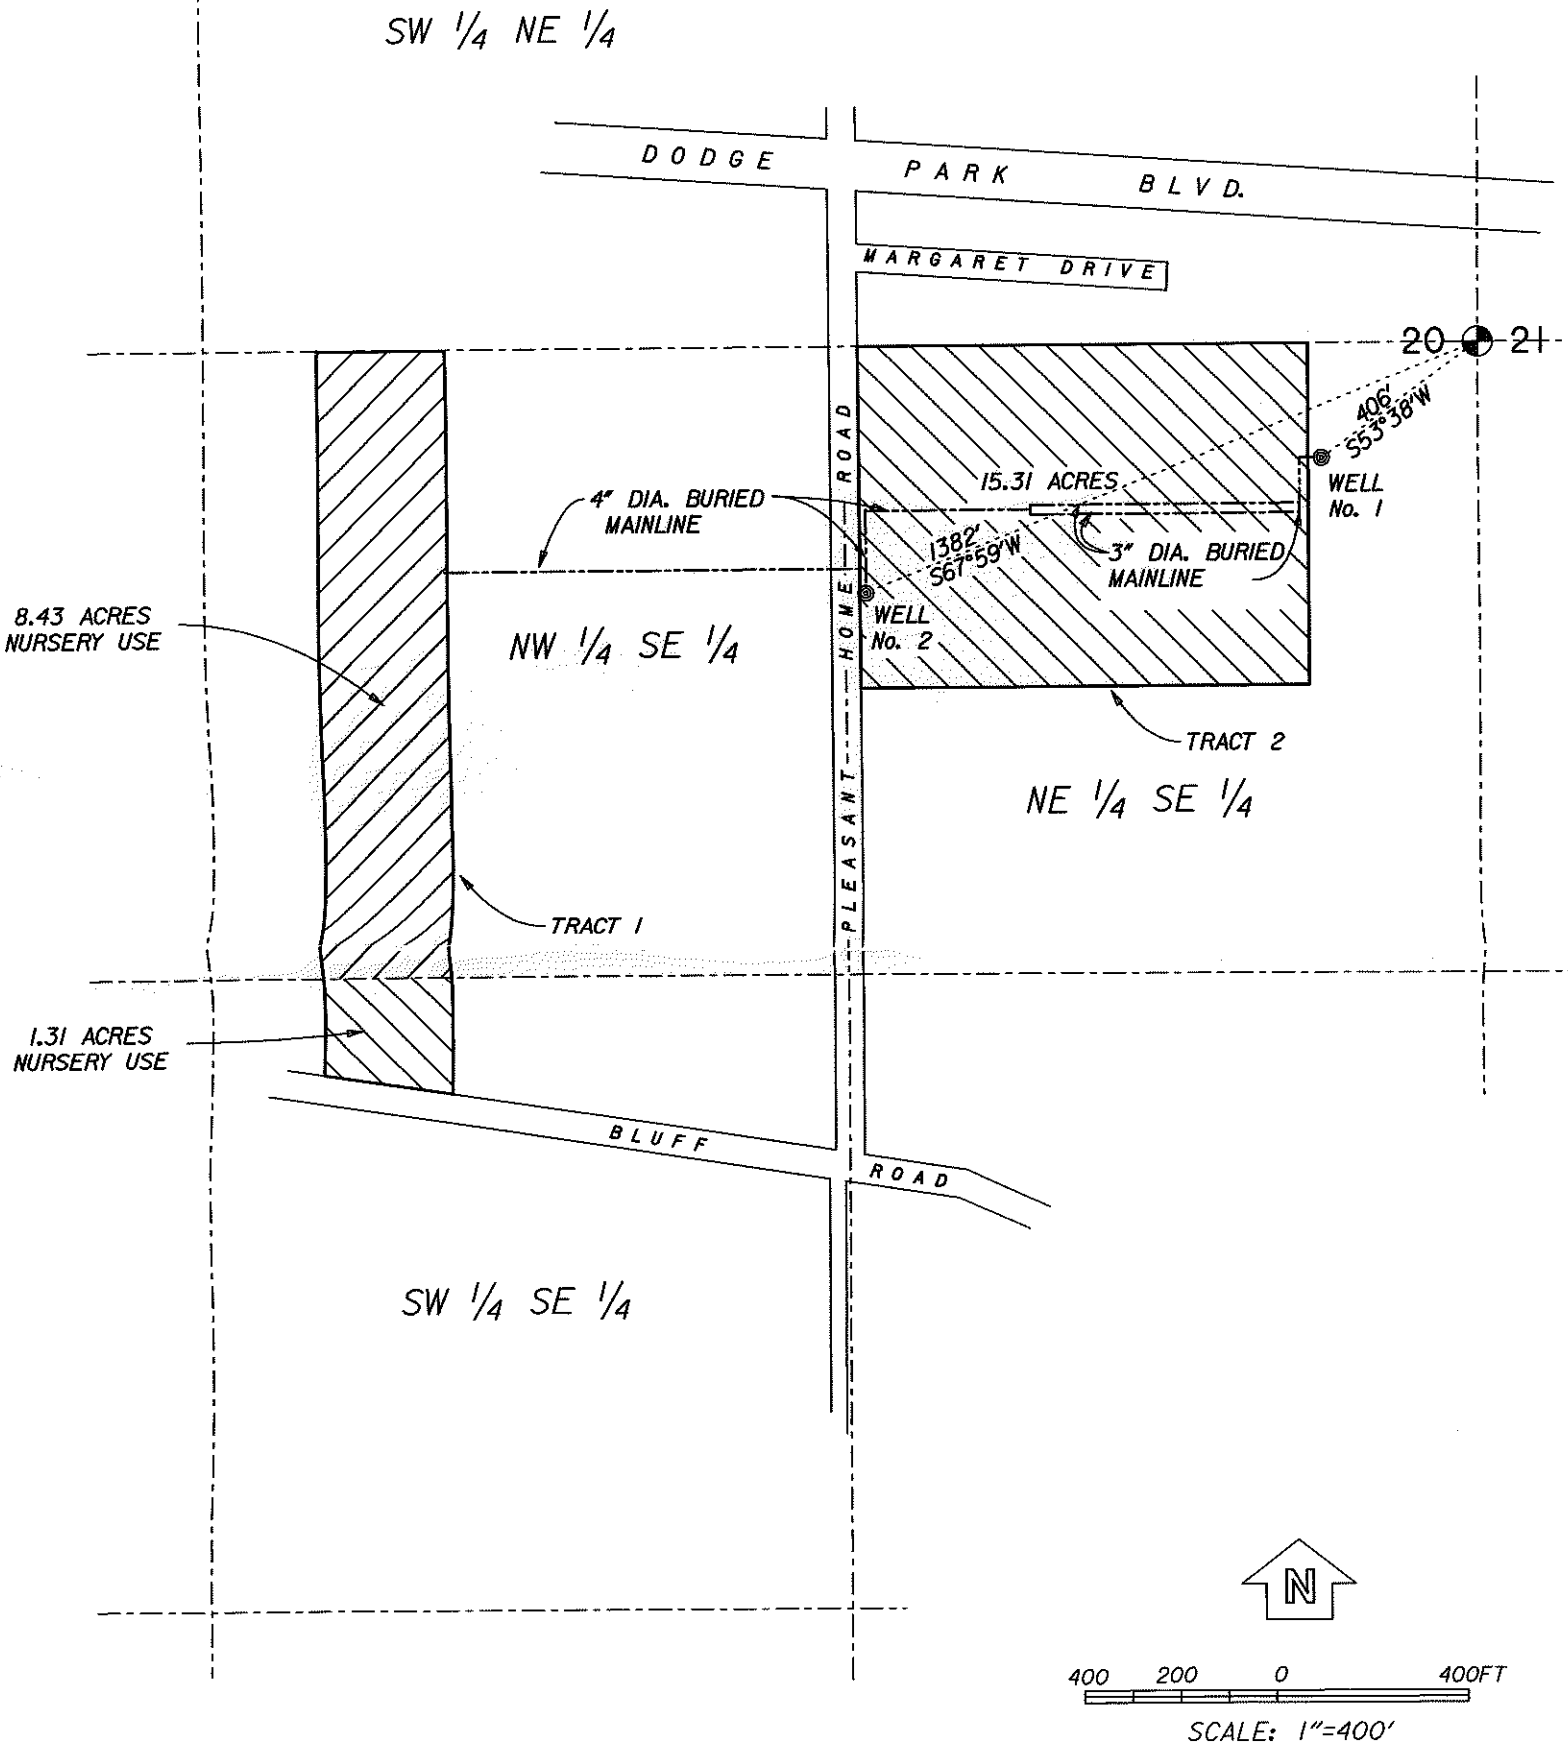


SECTION 20, T.1S., R.4E., W.M.
MULTNOMAH COUNTY, OREGON

This drawing is an exhibit for a Final Proof Survey. It is not a Land Survey. Property lines and/or other lines of occupation shown hereon are not represented by the undersigned to meet accuracy standards of Land Surveys.

Application No. **G-13898**

Permit No. **G-13476**

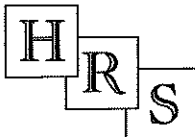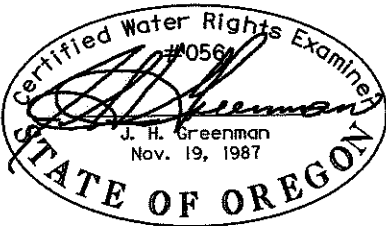

**HANER, ROSS &
SPORSEEN, INC.**
15 S.E. 82ND DRIVE
GLADSTONE, OREGON 97027

REARDON NURSERY, INC.
FINAL PROOF SURVEY