


HASSINGER FARMS CLAIM OF BENEFICIAL USE

Situated in Section 25, Township 2 South, Range 39 East and Section 30, Township 2 South, Range 40 East of the Willamette Meridian, Union County, Oregon

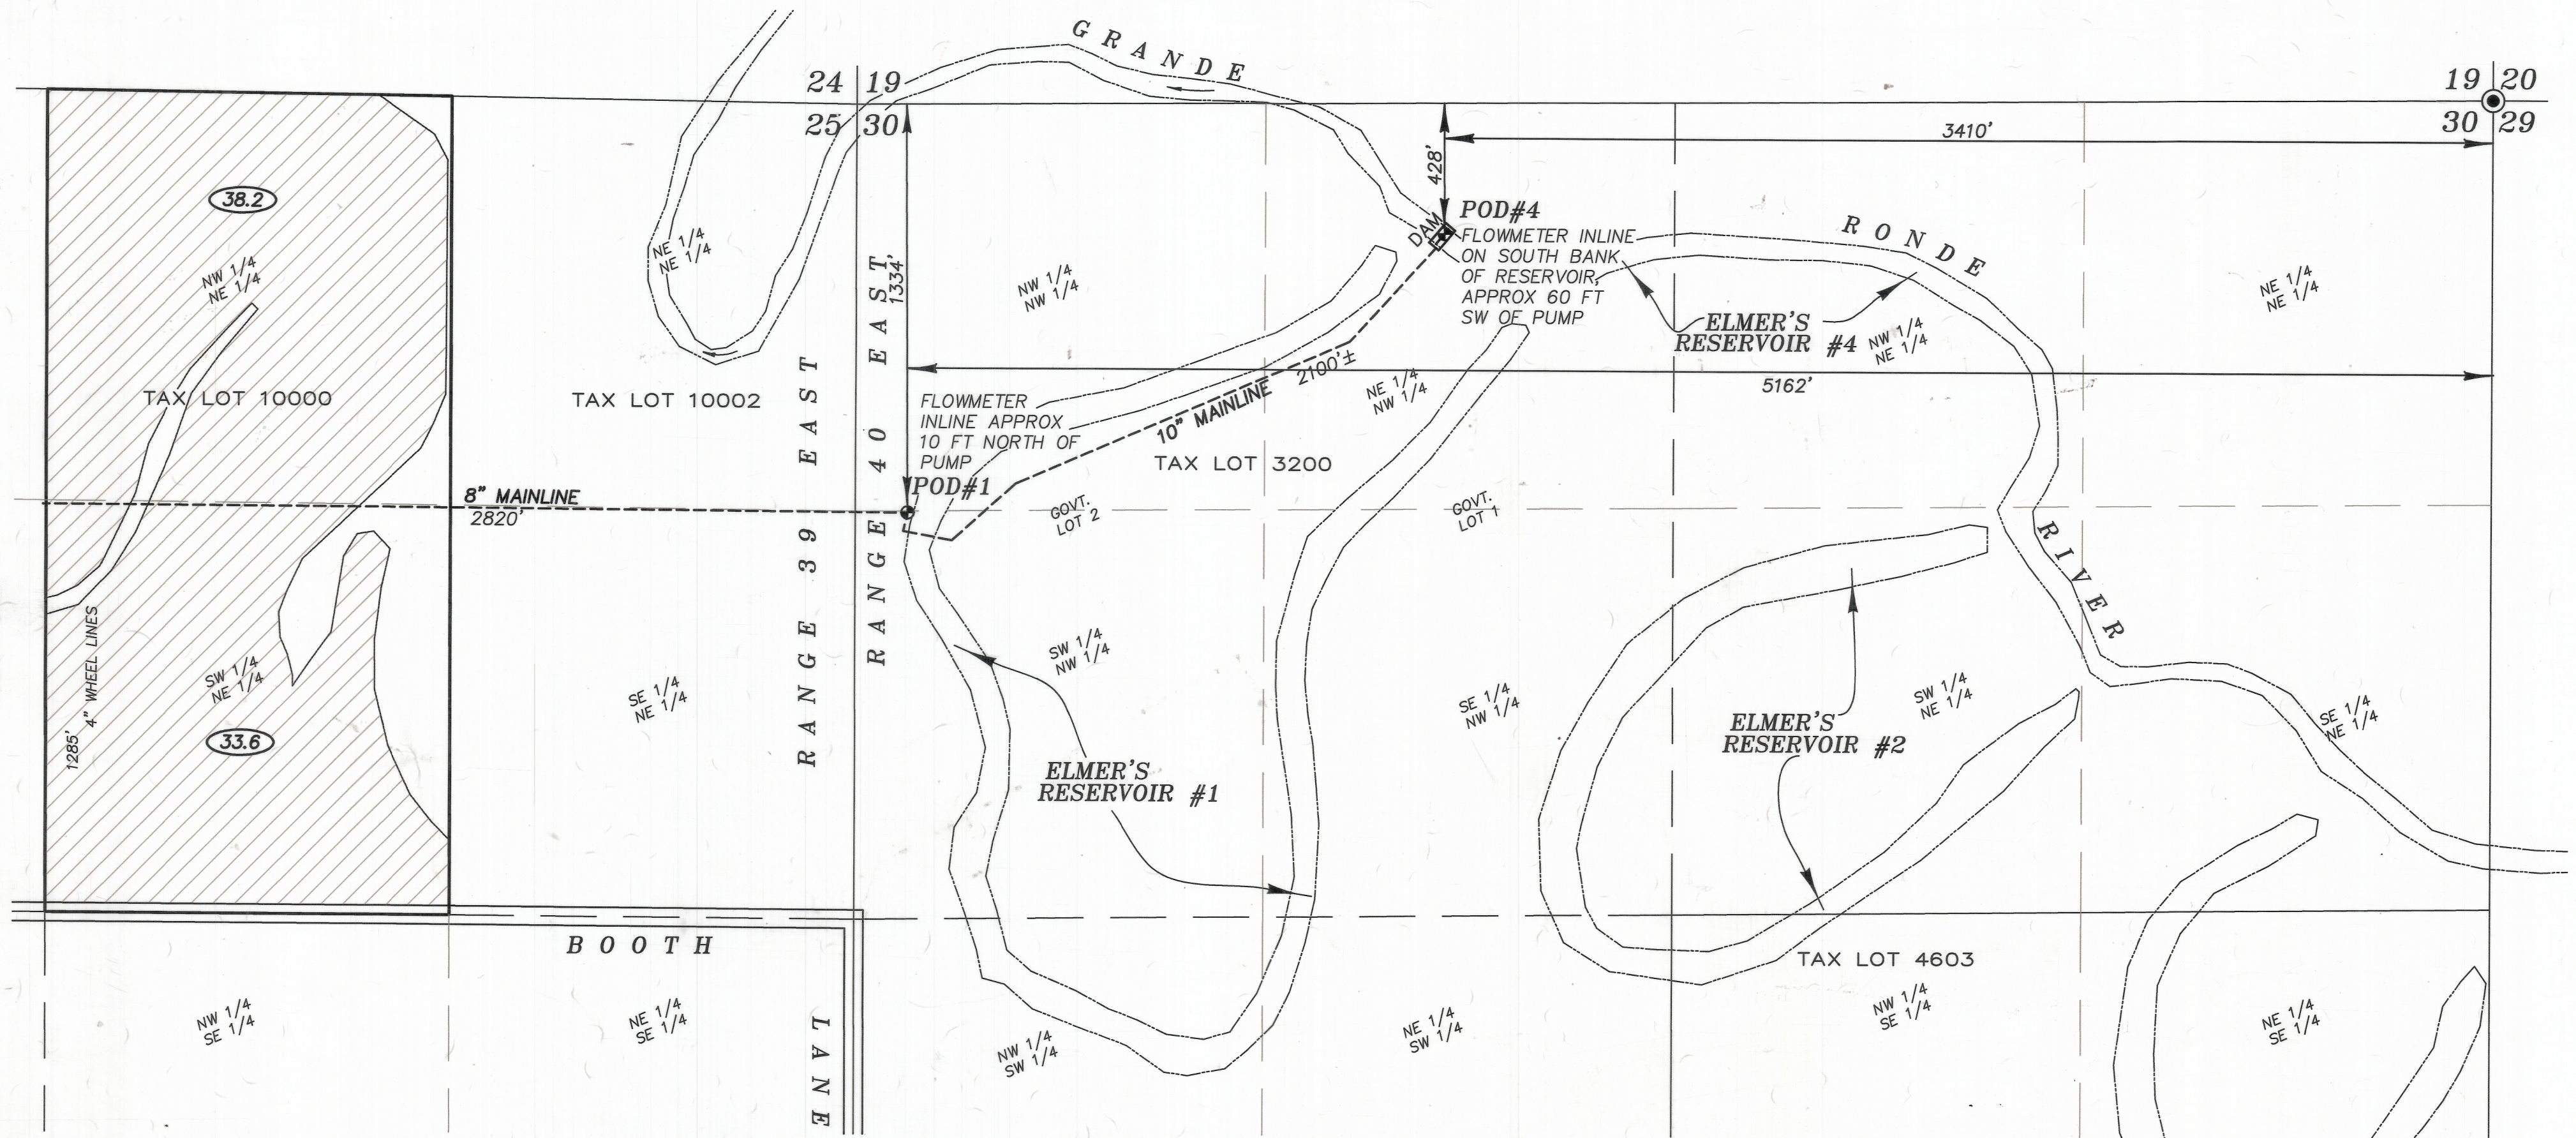

SCALE: 1"=400'

LEGEND

-  Area irrigated under Permit S-54998
-  Authorized Point of Diversion
-  Mainline
-  Irrigated Area

POINTS OF DIVERSION

- POD#1 1334 ft South and 5162 ft, West of the NE corner of Section 30, Township 2 South Range 40 East of the Willamette Meridian
- POD#4 428 ft South and 3410 ft, West of the NE corner of Section 30, Township 2 South Range 40 East of the Willamette Meridian



NOTE: The preparation of this map was for the purpose of identifying the location of proposed water rights and is not intended to provide dimensions or location of property ownership lines. Location information hereon was furnished by the applicant.

RECEIVED
AUG 30 2021
OWRD

MAP # 1313