


T28S R13W, WM, COOS COUNTY, OR

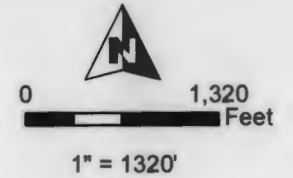

- POD
- POU IR 7/16/1976 Priority POD #1
- POU IR 7/16/1976 Priority Flood from POD #2
- POU IR 7/16/1976 Priority POD #3
- Township
- Section
- Quarter Quarter
- Tax Lot

POD Locations:


- #1 Coquille River: 2050' S, 1340' E of NW Cor Sec 5
- #2 Coquille River: 2630' S, 1180' E of NW Cor Sec 5
- #3 Slough: 2060' S, 1130' W of NW Cor Sec 5

Note: Land Irrigated from the Slough may be supplemented by the Coquille River when the Slough supply is not sufficient.

RECEIVED

JAN 29 2024

OWRD

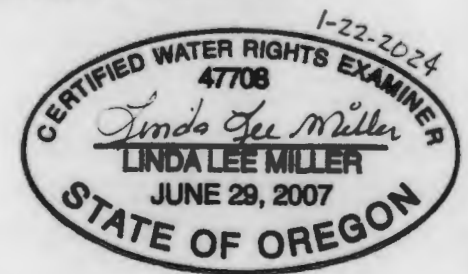

RENEWAL DATE 12/31/2024

CLAIM OF BENEFICIAL USE MAP La Franchi

Date: 1/18/2024

Ap S-54518 / Permit S-40887

Project #23006

This map is not intended to provide legal dimensions or locations of property ownership lines.

WATER RIGHT SERVICES, LLC
PO BOX 1830, BEND, OR 97709
WWW.OREGONWATER.US CCB # 197121
johnshort@usa.com 541-389-2837