


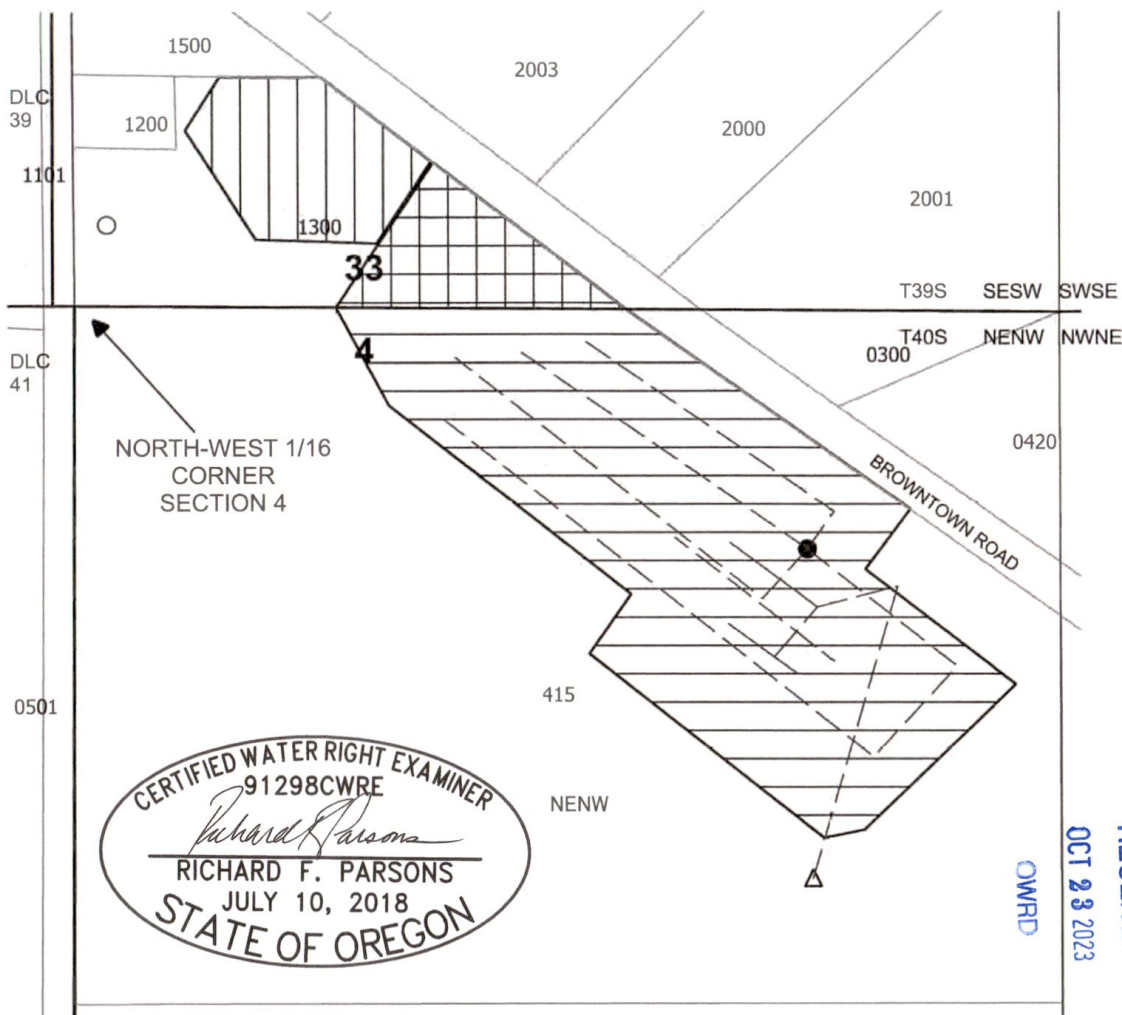

KIRIAKOV / HRISTOV
200 BROWNTOWN RD
CAVE JUNCTION, OR 97523

POA TRANSFER
APPLICATION G-7151
PERMIT G-6598
CERTIFICATE 54825

SITUATED IN
SECTION 4, TOWNSHIP 40 S
RANGE 7 W, W.M.
SECTION 33, TOWNSHIP 39 S
RANGE 7 W, W.M.
JOSEPHINE COUNTY OREGON

LEGEND

- △ JOSE 11597
765' SOUTH and 990' EAST
OF N-W 1/16 SECTION 4
- SUMP NO. 1
330' SOUTH and 990' EAST
OF N-W 1/16 SECTION 4
- SUMP NO. 2
110' NORTH and 40' EAST OF
N-W 1/16 SECTION 4
- C-58425 POU
SUMP NO. 1 - 7.1 ACS TOTAL
6.2 ACS - POA TRANSFER
TO JOSE 11597
- 0.9 ACS - NO TRANSFER
- SUMP NO. 2
2.1 ACS - NO TRANSFER
- PIPELINES




0 200 ft

This map is not intended to provide
legal dimensions or locations of
property ownership lines

ParsonsWater Consulting LLC
rick.parsons@parsonwater.com
541.499.0257 303.667.5067

RECEIVED
OCT 23 2023

T.39&40S.,R.7W.,W.M.

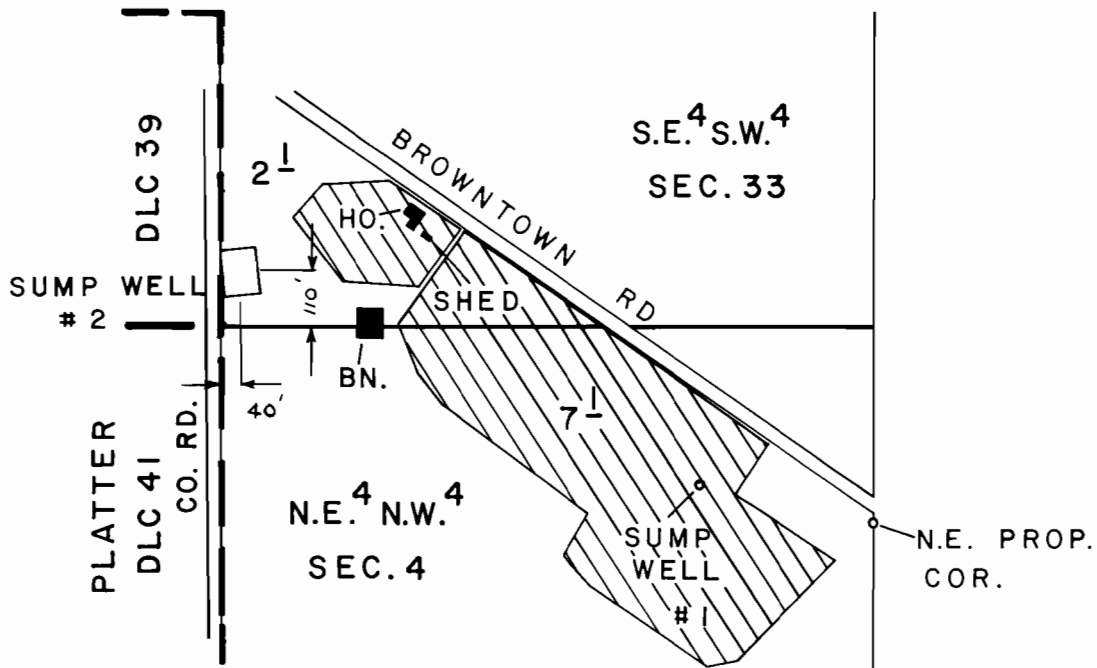

SUMP WELL # 1 LOC. - 330 FT. S. & 990 FT. E. FROM
N.W. COR., N.E. N.W., SEC. 4.

SCALE : 1" = 400 FT.

FINAL PROOF SURVEY UNDER

Application No. G-7151 Permit No. G-6598
IN NAME OF

GEORGE W. SICKLER

Surveyed JUN. 12 1979, by B. SUND

D.H.M.

P.T.S. - 1979 - 14 - B