


Township 1 South, Range 3 East, W.M.

Section 5

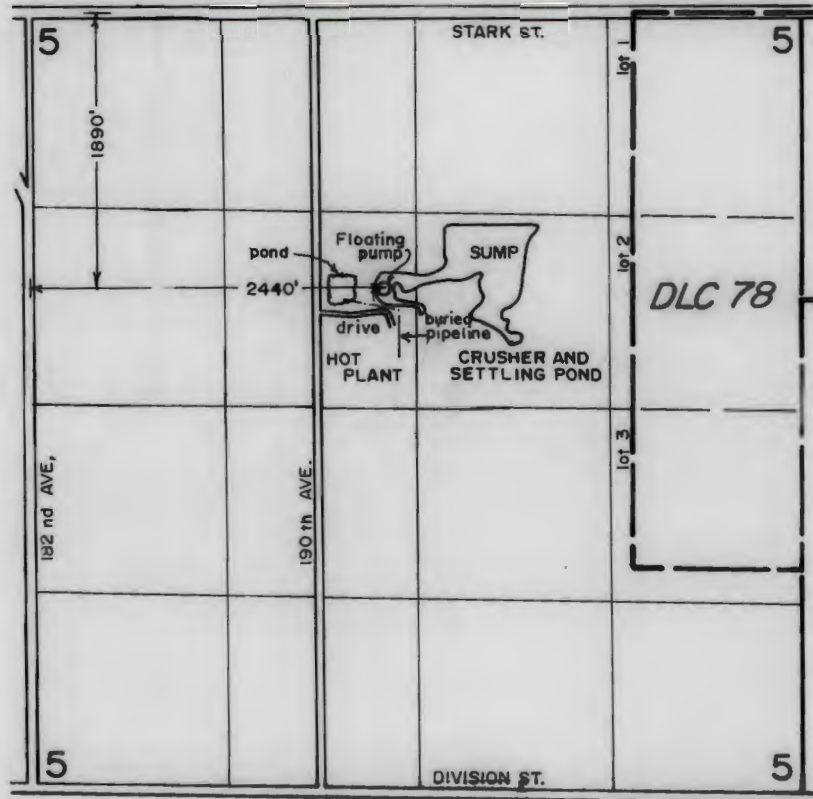

RECEIVED

SEP 30 1999

WATER RESOURCES DEPT.
SALEM, OREGON

FINAL PROOF SURVEY


under

Appl. No. G-12681, Per. No. G-12157

in name of

CIRCLE CONSTRUCTION

Sep. 21, 1999

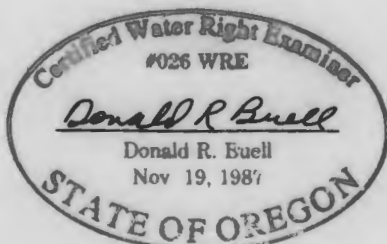

THIS MAP WAS PREPARED FOR THE PURPOSE OF IDENTIFYING THE LOCATION OF A WATER RIGHT ONLY AND IS NOT INTENDED TO PROVIDE LEGAL DIMENSIONS OR LOCATION OF PROPERTY OWNERSHIP LINES.