

ATTACH A-1

MAP FOR


Claim of Beneficial Use

S20, 21, 28, & 29, T10S, R3W, Linn County


Appl. S-88194, Permit S-55033



1 IN = 1320 FT
0 660 1320

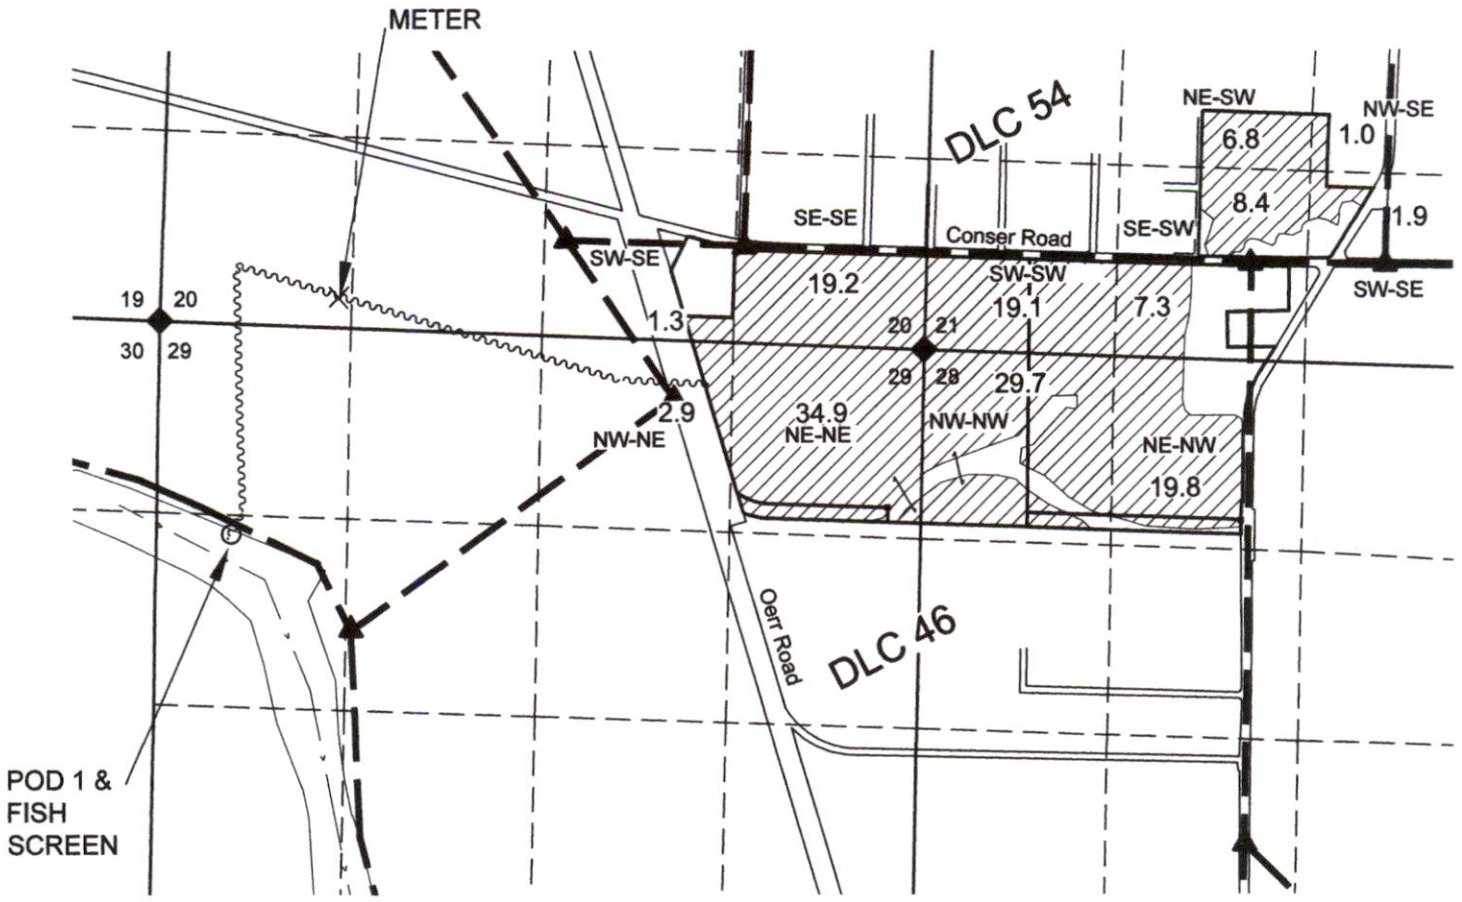

- NOTES:
- THIS MAP IS NOT INTENDED TO PROVIDE LEGAL DIMENSIONS OR LOCATIONS OF PROPERTY OWNERSHIP LINES.
 - THE DLC AND SECTION CORNERS HAVE BEEN LOCATED PER LINN COUNTY GIS SYSTEM. TAX LOT LINES ARE BASED ON TAX ASSESSOR MAPS FOR THE AREA.
 - THE WILLAMETTE RIVER AND IRRIGATION LINES ARE BASED ON A 2022 AERIAL PHOTO VIA GOOGLE AND FIELD CONFIRMATION.

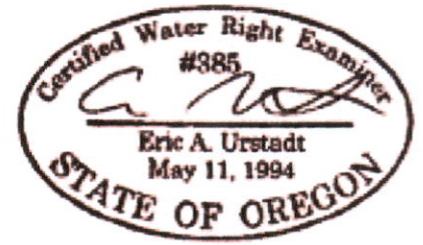

EXPIRES 30 JUN 2024

- LEGEND**
- ▲ DONATION LAND CLAIM (DLC) CORNER
 - ◆ SECTION OR QUARTER CORNER
 - POINT OF DIVERSION (POD 1)
 - - - QUARTER-QUARTER LINE
 - TAX LOT LINE
 - SECTION LINE
 - DLC LINE
 - STREAM
 - ~~~~~ CONVEYANCE PIPELINE
 - ▨ IRRIGATED AREA, ACRES BY Q-Q.

RECEIVED
 DEC 29 2022
 OWRD
 SALEM, OREGON

MAP BY:
ASPEN RURAL LAND CONSULTING
 ERIC URSTADT, PE, PLS
 971-250-1520
 Jun 2017
 WWL-MLRBRG-E-31