


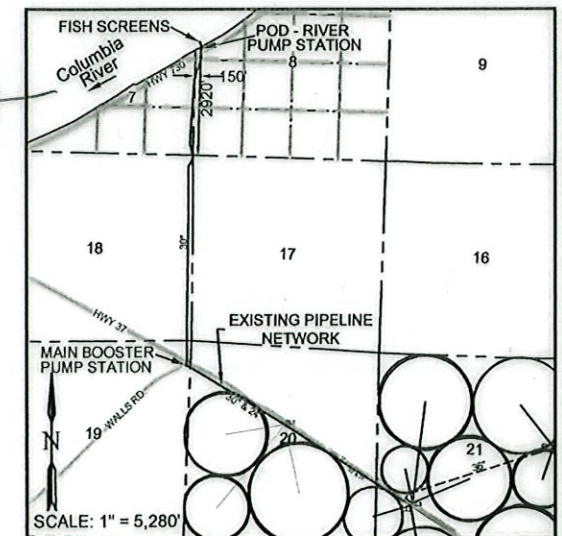
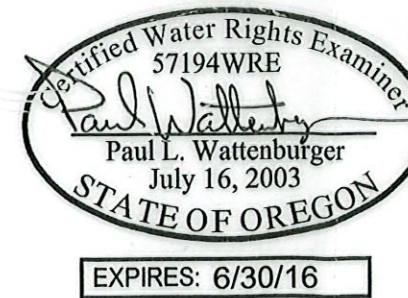
**LEGEND**

TL 1380 TAX LOT NUMBER

 TRANSFER OF 32.45 AC OF CERT 44107 UNDER TRANSFER T-11404

**POINT OF DIVERSION**

SW 1/4 NW 1/4, SECTION 8, T5N, R30E, W.M.; 2,920 FEET NORTH AND 150 FEET EAST FROM CORNER, SECTION 8.



**Claim of Beneficial Use Map**

For Transfer T-11404 from Certificate 44107

In the Name of St. Hilaire Brothers Hermiston Farm, LLC

August 13th, 2014

THIS MAP WAS PREPARED FOR THE PURPOSE OF IDENTIFYING THE LOCATION OF A WATER RIGHT ONLY AND IS NOT INTENDED TO PROVIDE LEGAL DIMENSIONS OR LOCATION OF PROPERTY OWNERSHIP LINES.

RECEIVED BY OWRD

DEC 08 2014

SALEM, OR

Township 5 North, Range 30 East, W.M.

COBU MAP # 878