


12-H, INC.  
 WATER RIGHT MAP FOR CERTIFICATE 68707  
 T4N, R27E, W.M.  
 MAP 2 OF 7

MORROW COUNTY

UMATILLA COUNTY

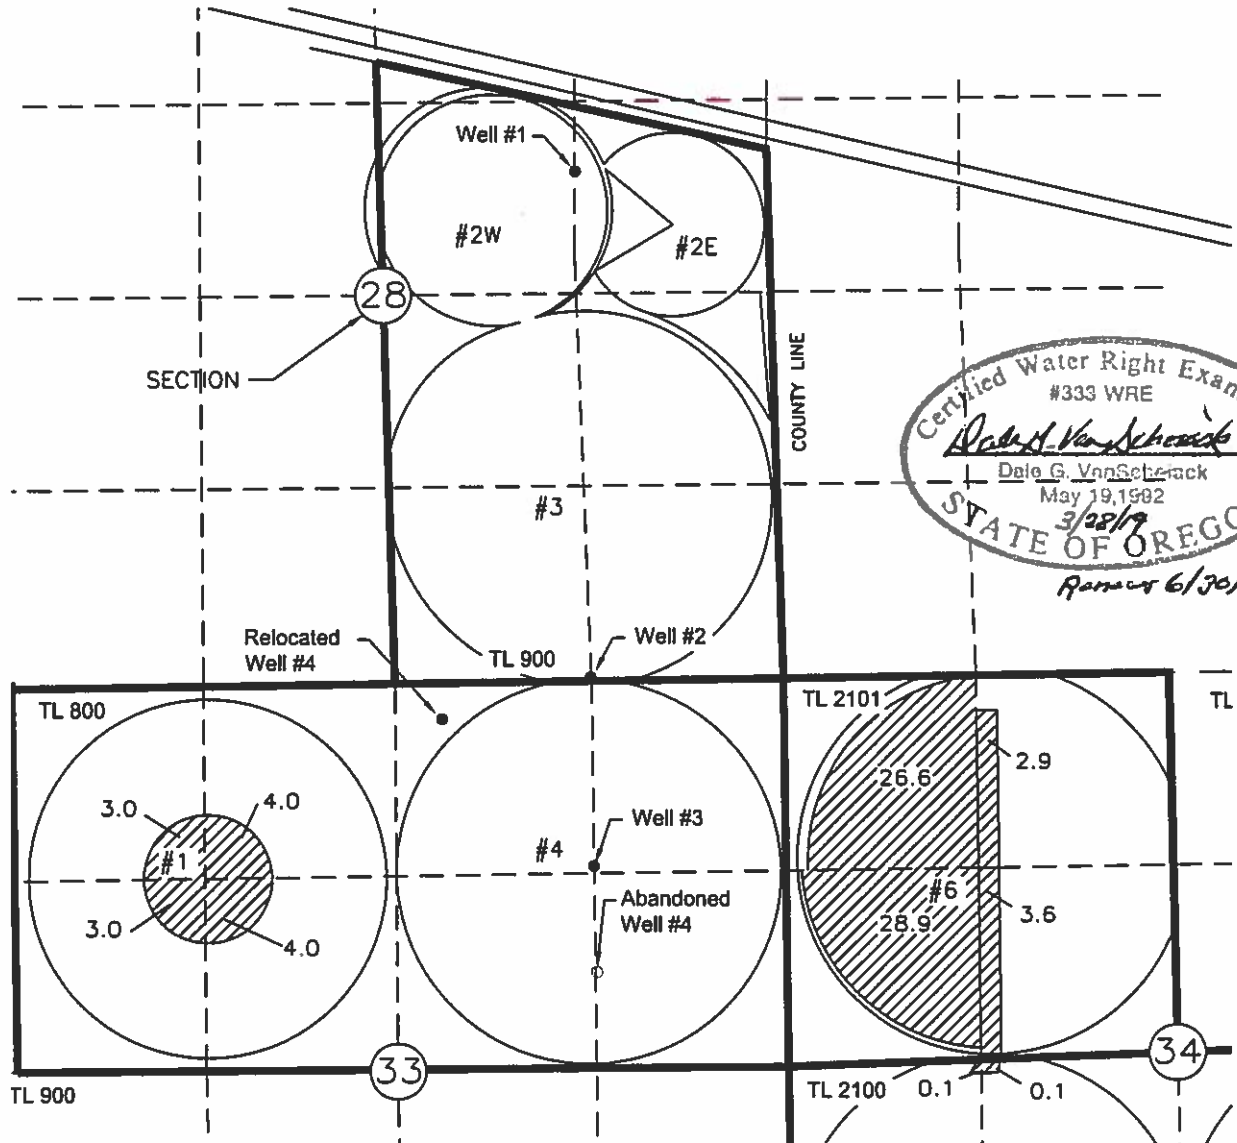


Certified Water Right Examiner  
 #333 WRE  
*Dale G. VannSchreck*  
 Dale G. VannSchreck  
 May 19, 1982  
 3/28/19  
 STATE OF OREGON  
 Renewed 6/30/20

OWRD  
 APR 08 2019  
 RECEIVED

AUTHORIZED POINTS OF APPROPRIATION  
 WELL #1 LOCATED 3180'N AND 1470'W FROM  
 THE SE COR SEC 28  
 WELL #2 LOCATED 20'N AND 1350'W FROM  
 THE SE COR SEC 28  
 WELL #3 LOCATED 1270'S AND 1350'W FROM  
 THE NE COR SEC 33  
 WELL #4 LOCATED 1940'S AND 1350'W FROM  
 THE NE COR SEC 33

RELOCATED  
 WELL #4 LOCATED 290'S AND 2330'W FROM  
 THE NE COR SEC 33

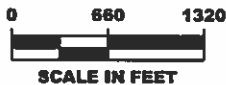

AREA OF WATER RIGHT

NOTE:  
 THE PURPOSE OF THIS MAP IS TO IDENTIFY THE APPROXIMATE LOCATION OF THE WATER  
 RIGHT. IT IS NOT INTENDED TO PROVIDE INFORMATION RELATIVE TO THE LOCATION OF  
 PROPERTY OWNERSHIP BOUNDARY LINES.

13164