


12-H, INC.
 WATER RIGHT MAP FOR CERTIFICATE 68708
 T4N, R27E, W.M.
 MAP 3 OF 7

MORROW COUNTY

UMATILLA COUNTY

OWRD
 APR 08 2019
 RECEIVED

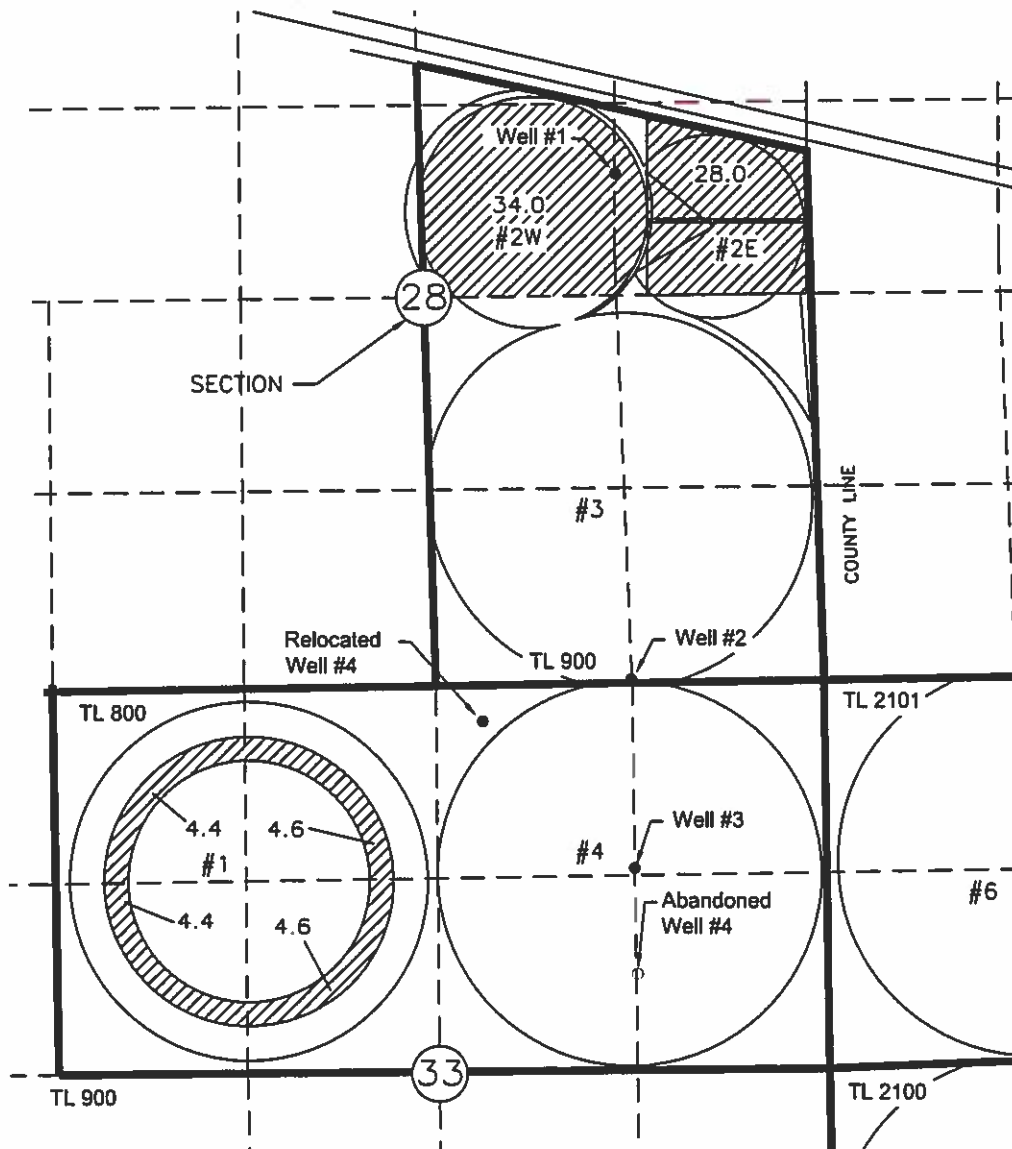

AREA OF WATER RIGHT

Certified Water Right Examiner
 #333 WRE
Dale G. VanScherack
 Dale G. VanScherack
 May 19, 1992
 3/28/19
 STATE OF OREGON
 Renewed 6/30/20

AUTHORIZED POINTS OF APPROPRIATION
 WELL #1 LOCATED 3180'N AND 1470'W FROM THE SE COR SEC 28
 WELL #2 LOCATED 20'N AND 1350'W FROM THE SE COR SEC 28
 WELL #3 LOCATED 1270'S AND 1350'W FROM THE NE COR SEC 33
 WELL #4 LOCATED 1940'S AND 1350'W FROM THE NE COR SEC 33

RELOCATED
 WELL #4 LOCATED 290'S AND 2330'W FROM THE NE COR SEC 33

NOTE:
 THE PURPOSE OF THIS MAP IS TO IDENTIFY THE APPROXIMATE LOCATION OF THE WATER RIGHT. IT IS NOT INTENDED TO PROVIDE INFORMATION RELATIVE TO THE LOCATION OF PROPERTY OWNERSHIP BOUNDARY LINES.

13164