


MAP TO ACCOMPANY APPLICATION TO CHANGE PLACE OF USE ON SILVIES RIVER DECREE & CERTIFICATE 46974 FOR LCL PROPERTIES, LLC

RECEIVED


JAN 23 2023


OWRD

TAX LOT 101
IN SECTION 16, TOWNSHIP 23 SOUTH, RANGE 31 EAST, W.M.
HARNEY COUNTY, OREGON

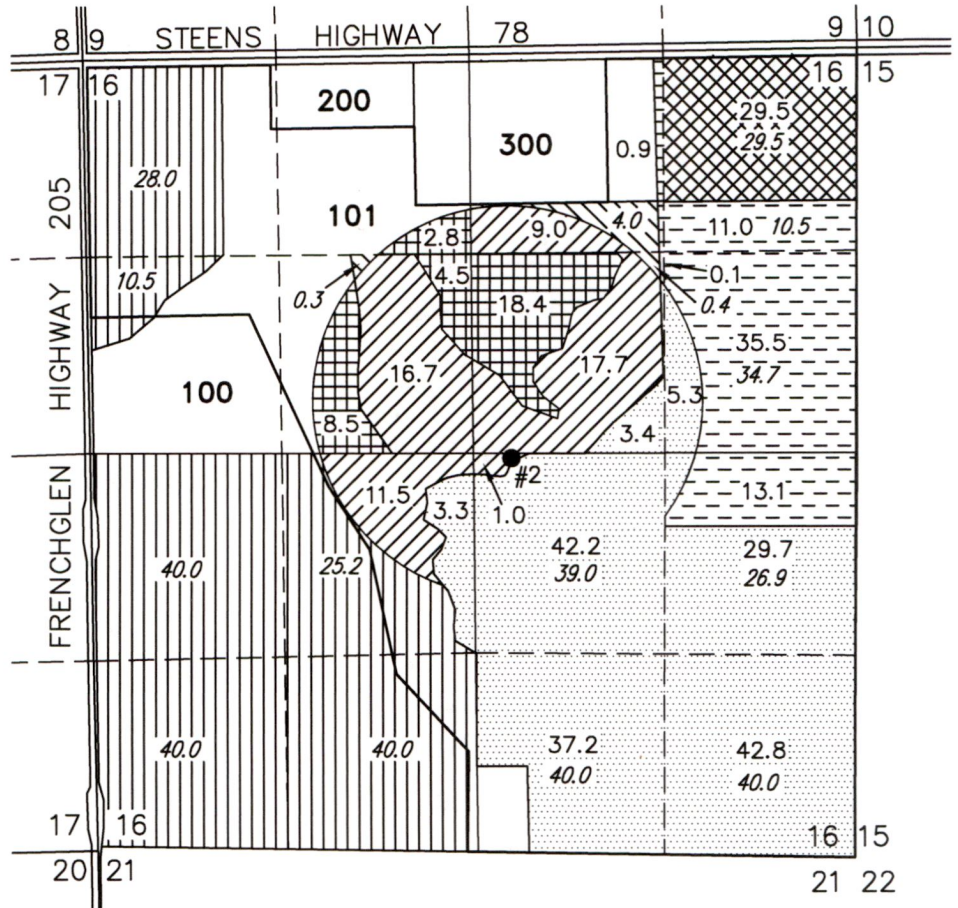





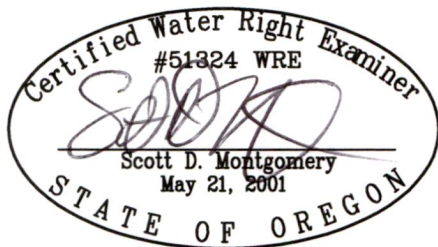


● #2 (HARN 463) LOCATED IN THE NW
1/4 SE 1/4 SECTION 16, AND 2780'
S AND 2910' E FROM THE NW
CORNER OF SECTION 16.

 183.7 ACRES IR FROM DECREE
REMAIN, AS SHOWN.



RENEWAL DATE: 12/31/2024

THIS MAP IS FOR THE PURPOSE OF LOCATING A WATER
RIGHT ONLY AND HAS NO INTENT TO PROVIDE LEGAL
DIMENSIONS OR THE LOCATION OF PROPERTY LINES.

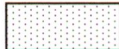-  34.2 ACRES IR FROM DECREE & 34.2 ACRES IS FROM
CERTIFICATE 46974 TRANSFERRED "ON", AS SHOWN.
-  55.9 ACRES IS FROM CERTIFICATE 46974 TRANSFERRED
"ON" & 55.9 ACRES REMAIN FROM DECREE, AS SHOWN.
-  4.7 ACRES IR FROM DECREE TRANSFERRED "OFF", AS
SHOWN.
-  59.6 ACRES IS FROM CERTIFICATE 46974 TRANSFERRED
"OFF" & 58.3 ACRES IR FROM DECREE REMAIN, AS SHOWN.
-  1.0 ACRES IS FROM CERTIFICATE 46974 TRANSFERRED
"OFF", AS SHOWN.
-  29.5 ACRES IR FROM DECREE & 29.5 ACRES IS FROM
CERTIFICATE 46974 TRANSFERRED "OFF", AS SHOWN.
-  157.9 ACRES IR FROM DECREE & 163.9 ACRES IS FROM
CERTIFICATE 46974 REMAIN, AS SHOWN.

PROJECT No. 22-180

PREPARED AT THE REQUEST OF:

LCL PROPERTIES, LLC
P.O. BOX 340
BURNS, OR 97720


**ALL POINTS ENGINEERING
& SURVEYING, INC.**



P.O. BOX 767
TERREBONNE, OREGON 97760
(541) 548-5833 PH
scott@apeands.com
www.APEandS.com

14155

T.23S.R.31E.W.M.

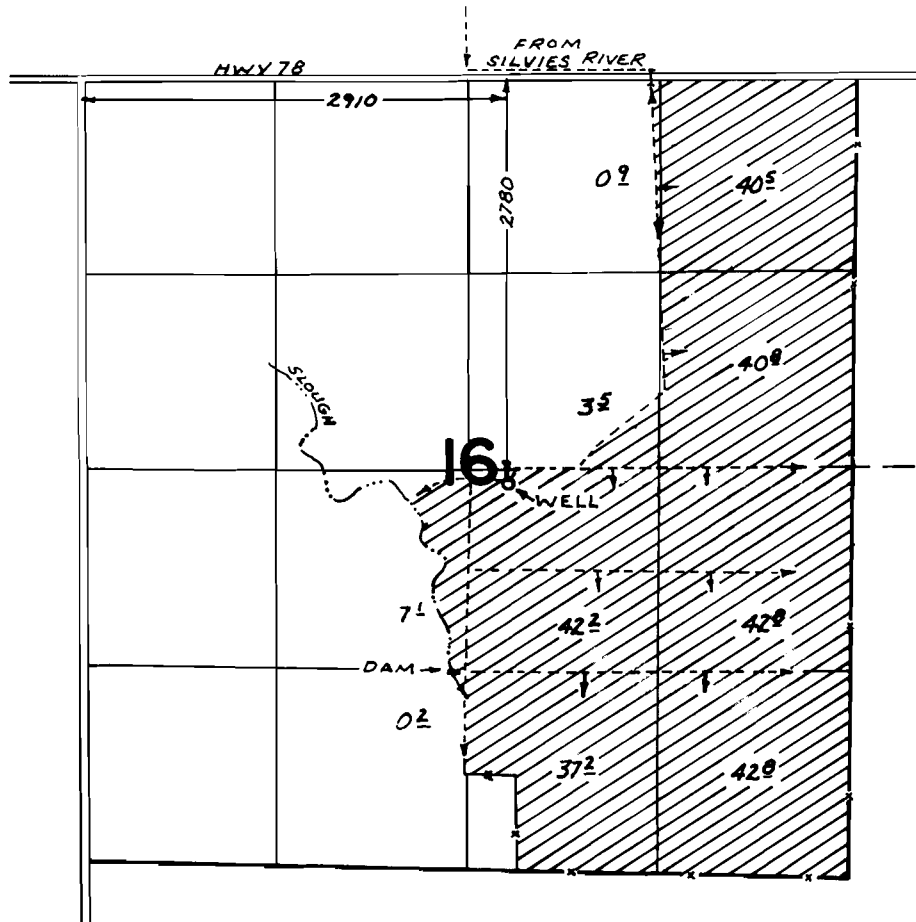

FINAL PROOF SURVEY UNDER

Application No. *G-5214* Permit No. *G-5077*
IN NAME OF

SAM & OR ARLICE GUNDERSON

Surveyed *AUG. 12, 1976*, by *R. MUCKEN*