


CLAIM OF BENEFICIAL USE
APPLICATION G-14869 - PERMIT G-13688
SW1/4NE1/4, SEC. 5, T.39S., R.5W., W.M.
JOSEPHINE COUNTY, OREGON
FOR
DANIEL K. GINTHER

RECEIVED BY OWRD

JUN 18 2014

SALEM, OR

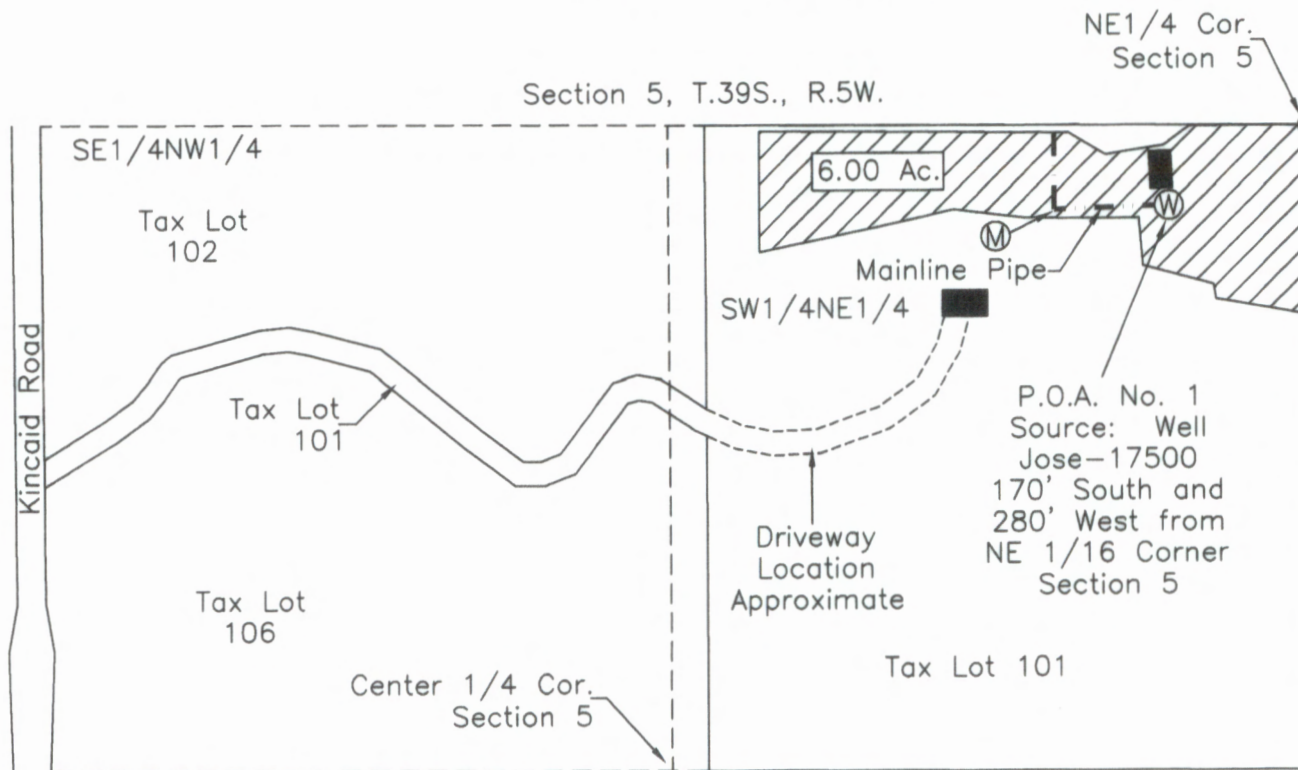

Scale: 1"=400'
Date: April 10, 2014


LEGEND

- Found Survey Monument
- Denotes Building
- Denotes Property Line
- - - Denotes Mainline Pipe
- ▨ Denotes Area Under Permit No. 13688 Priority Date Nov. 27 1998.
- Ⓜ Denotes Well L-114311
- Ⓜ Denotes Flow Meter

This map was prepared for the purpose of identifying the location of a water right only and is not intended to provide legal dimensions or location of property ownership.

PROJECT: 14-10 Ginther

HAROLD L. CENTER
2604 David Lane
Medford, OR. 97504
Phone 541-535-6108
Oregon Certificate No. 152

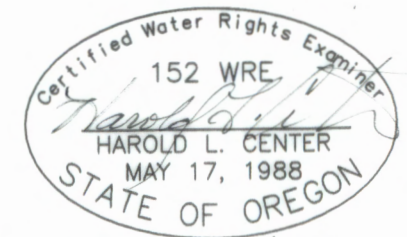

Renews: 12/31/15