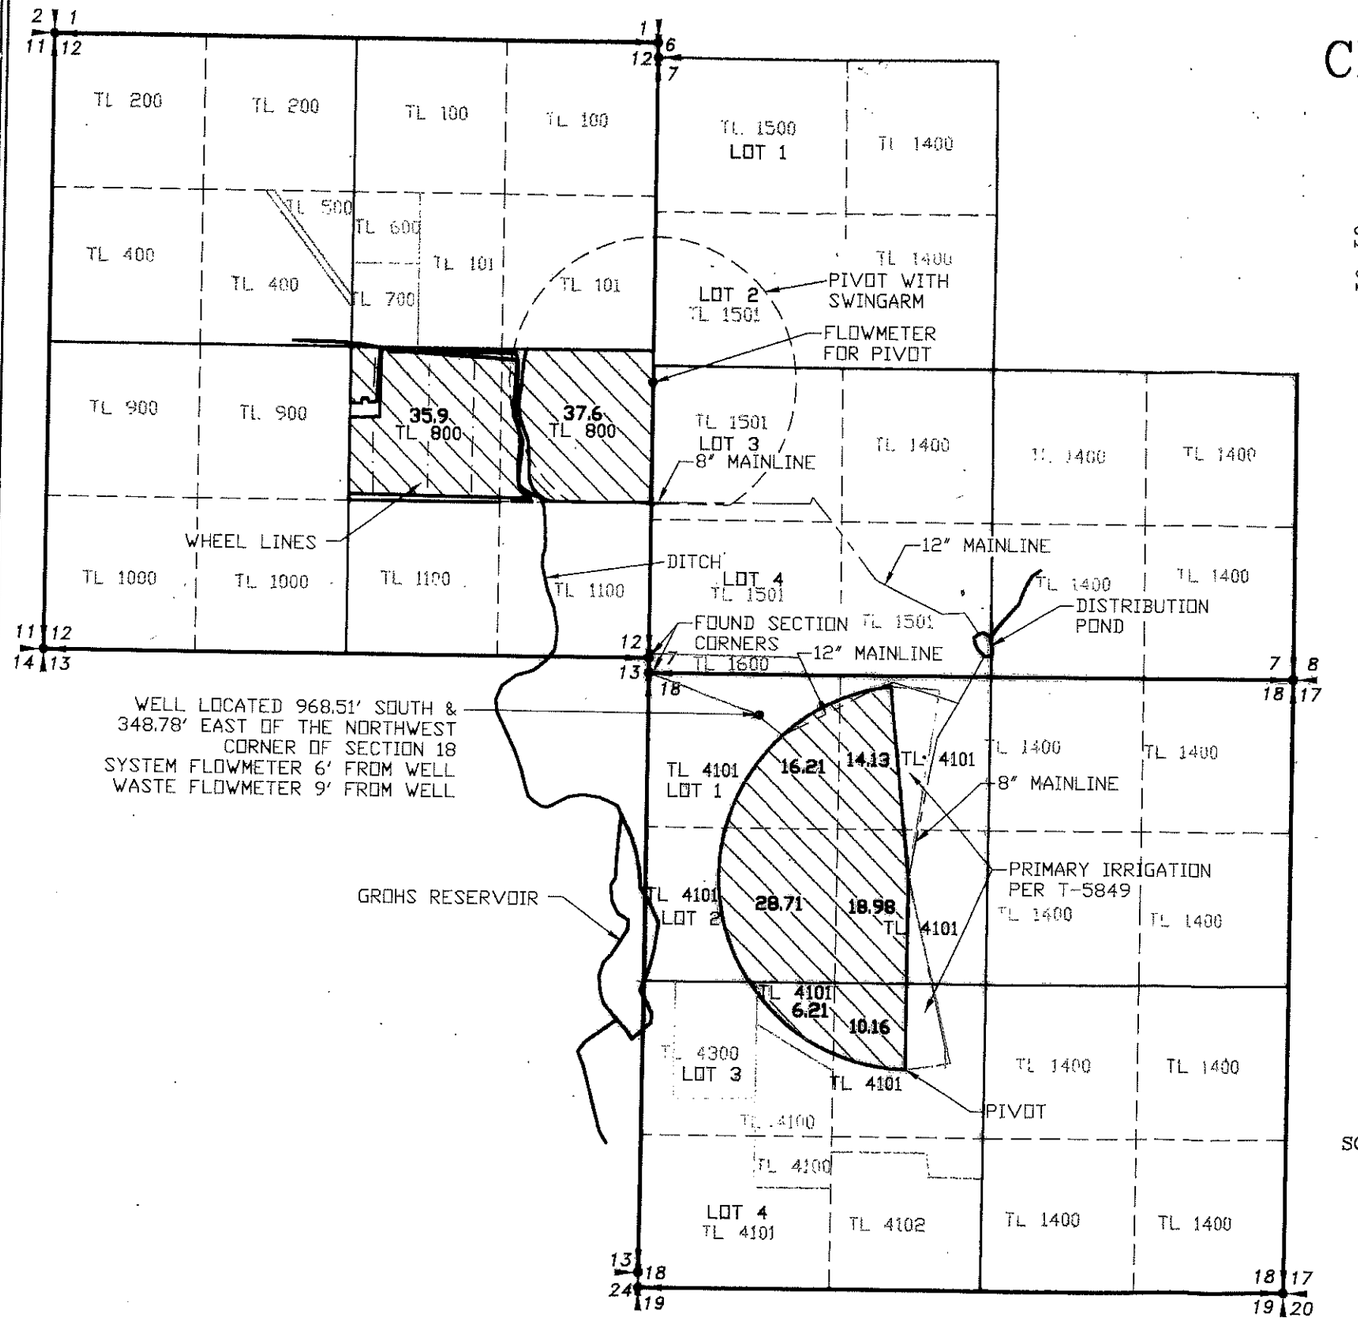

CLAIM OF BENEFICIAL USE MAP

FOR

LESTER STURM

SECTION 12, TOWNSHIP 41 SOUTH RANGE 12 EAST
SECTION 18, TOWNSHIP 41 SOUTH RANGE 13 EAST
KLAMATH COUNTY, OREGON

Certified Water Right Examiner
006
Darryl L. Anderson
Nov.19, 1997
STATE OF OREGON

RENEWAL 12/31/23

RECEIVED
NOV 30 2023
OWRD

LEGEND

- SECTION LINE
- 1/4 SECTION LINE
- 1/16 SECTION LINE
- IRRIGATION MAIN LINE
- WHEEL LINE
- SUPPLEMENTAL IRRIGATION

N

SCALE: 1" =1320'

APPLICATION NO. G-16855

PERMIT NO. G-16334

NOTE:
PREPARATION OF THIS MAP IS FOR IDENTIFYING PROPOSED WATER RIGHTS ONLY. IT HAS NO INTENT TO PROVIDE LOCATIONS OR DIMENSIONS OF PROPERTY BOUNDARIES.

MAP 470
folder 'P'

REVISION	BY
11/13/2023	RC

ANDERSON ENGINEERING AND SURVEYING, INC.
P.O. BOX 28
LAKEVIEW, OREGON
97630
(541) 947-4407
FAX: 947-2321

FOR: LESTER STURM
36121 STASTNY RD
MA[illegible] OR
9[illegible]

CLAIM OF BENEFICIAL USE
APPLICATION NO. G-16855
PERMIT NO. G-16334

DATE:	8-13-08
SCALE:	1"=1320'
DWG. BY:	R.C.
JOB:	2007-072
FILE:	2007-072
SHEET:	1 OF 1