


T.12S., R.41E., W.M.

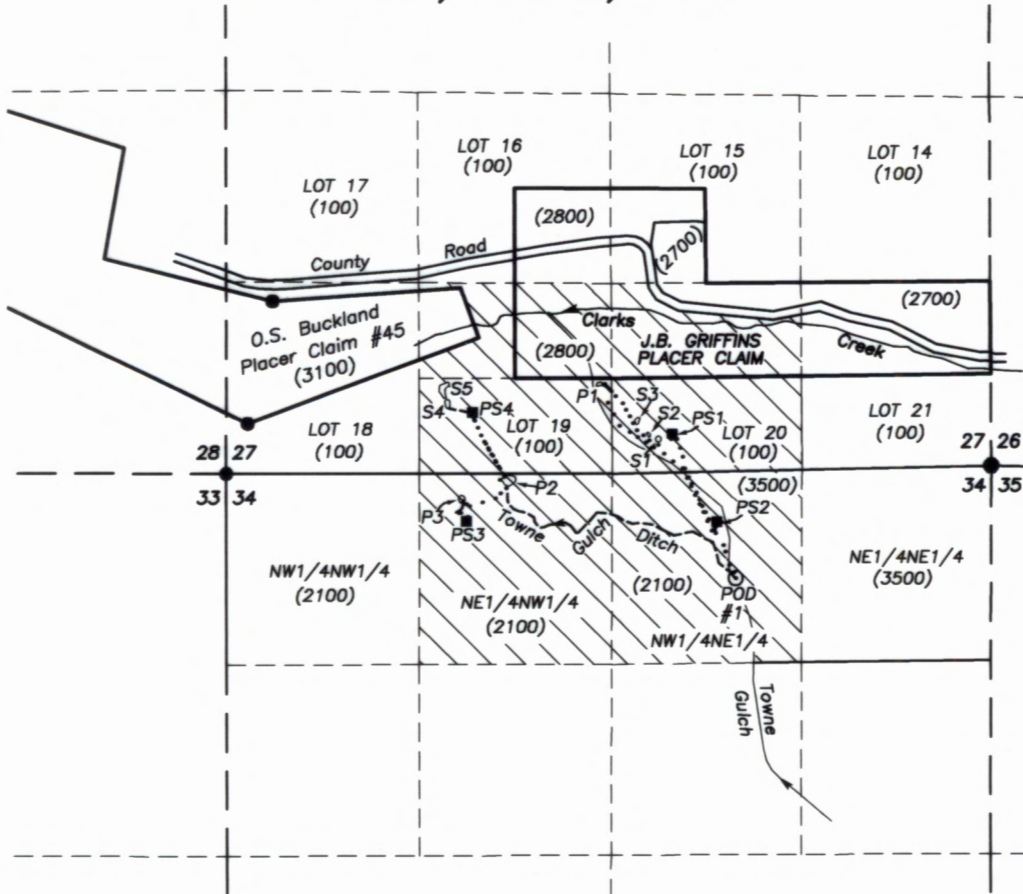

SCALE: 1"=1320'

RECEIVED

NOV 14 2011

WATER RESOURCES DEPT
SALEM, OREGON

○ POD #1 is 780 ft South and 1750 ft. West of the Northeast Corner Sec. 34

FINAL PROOF SURVEY UNDER PERMIT NO. 46731

APPLICATION NO. 60352

FOR MINING

IN NAME OF
U.S. DEPARTMENT OF THE INTERIOR
BUREAU OF LAND MANAGEMENT

BY

ROBERT D. BAGETT
217 N. CANYON BLVD.
JOHN DAY, OREGON 97845

SURVEY COMPLETED: JULY 8, 2010

Place of Use

● Found marked stone monument

..... Pipe line

PS1 Plant site

P1 Pumping Pond -Bulge in system

S1 Settling pond

(100) Tax lot No.

NOTE: The preparation of this map was for the purpose of identifying the location of the proposed water right and has no intent to provide dimensions or location of property ownership lines.

