



T. 24 S., R. 27 & 28 E., W.M.

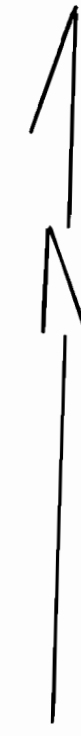

1" = 1320'

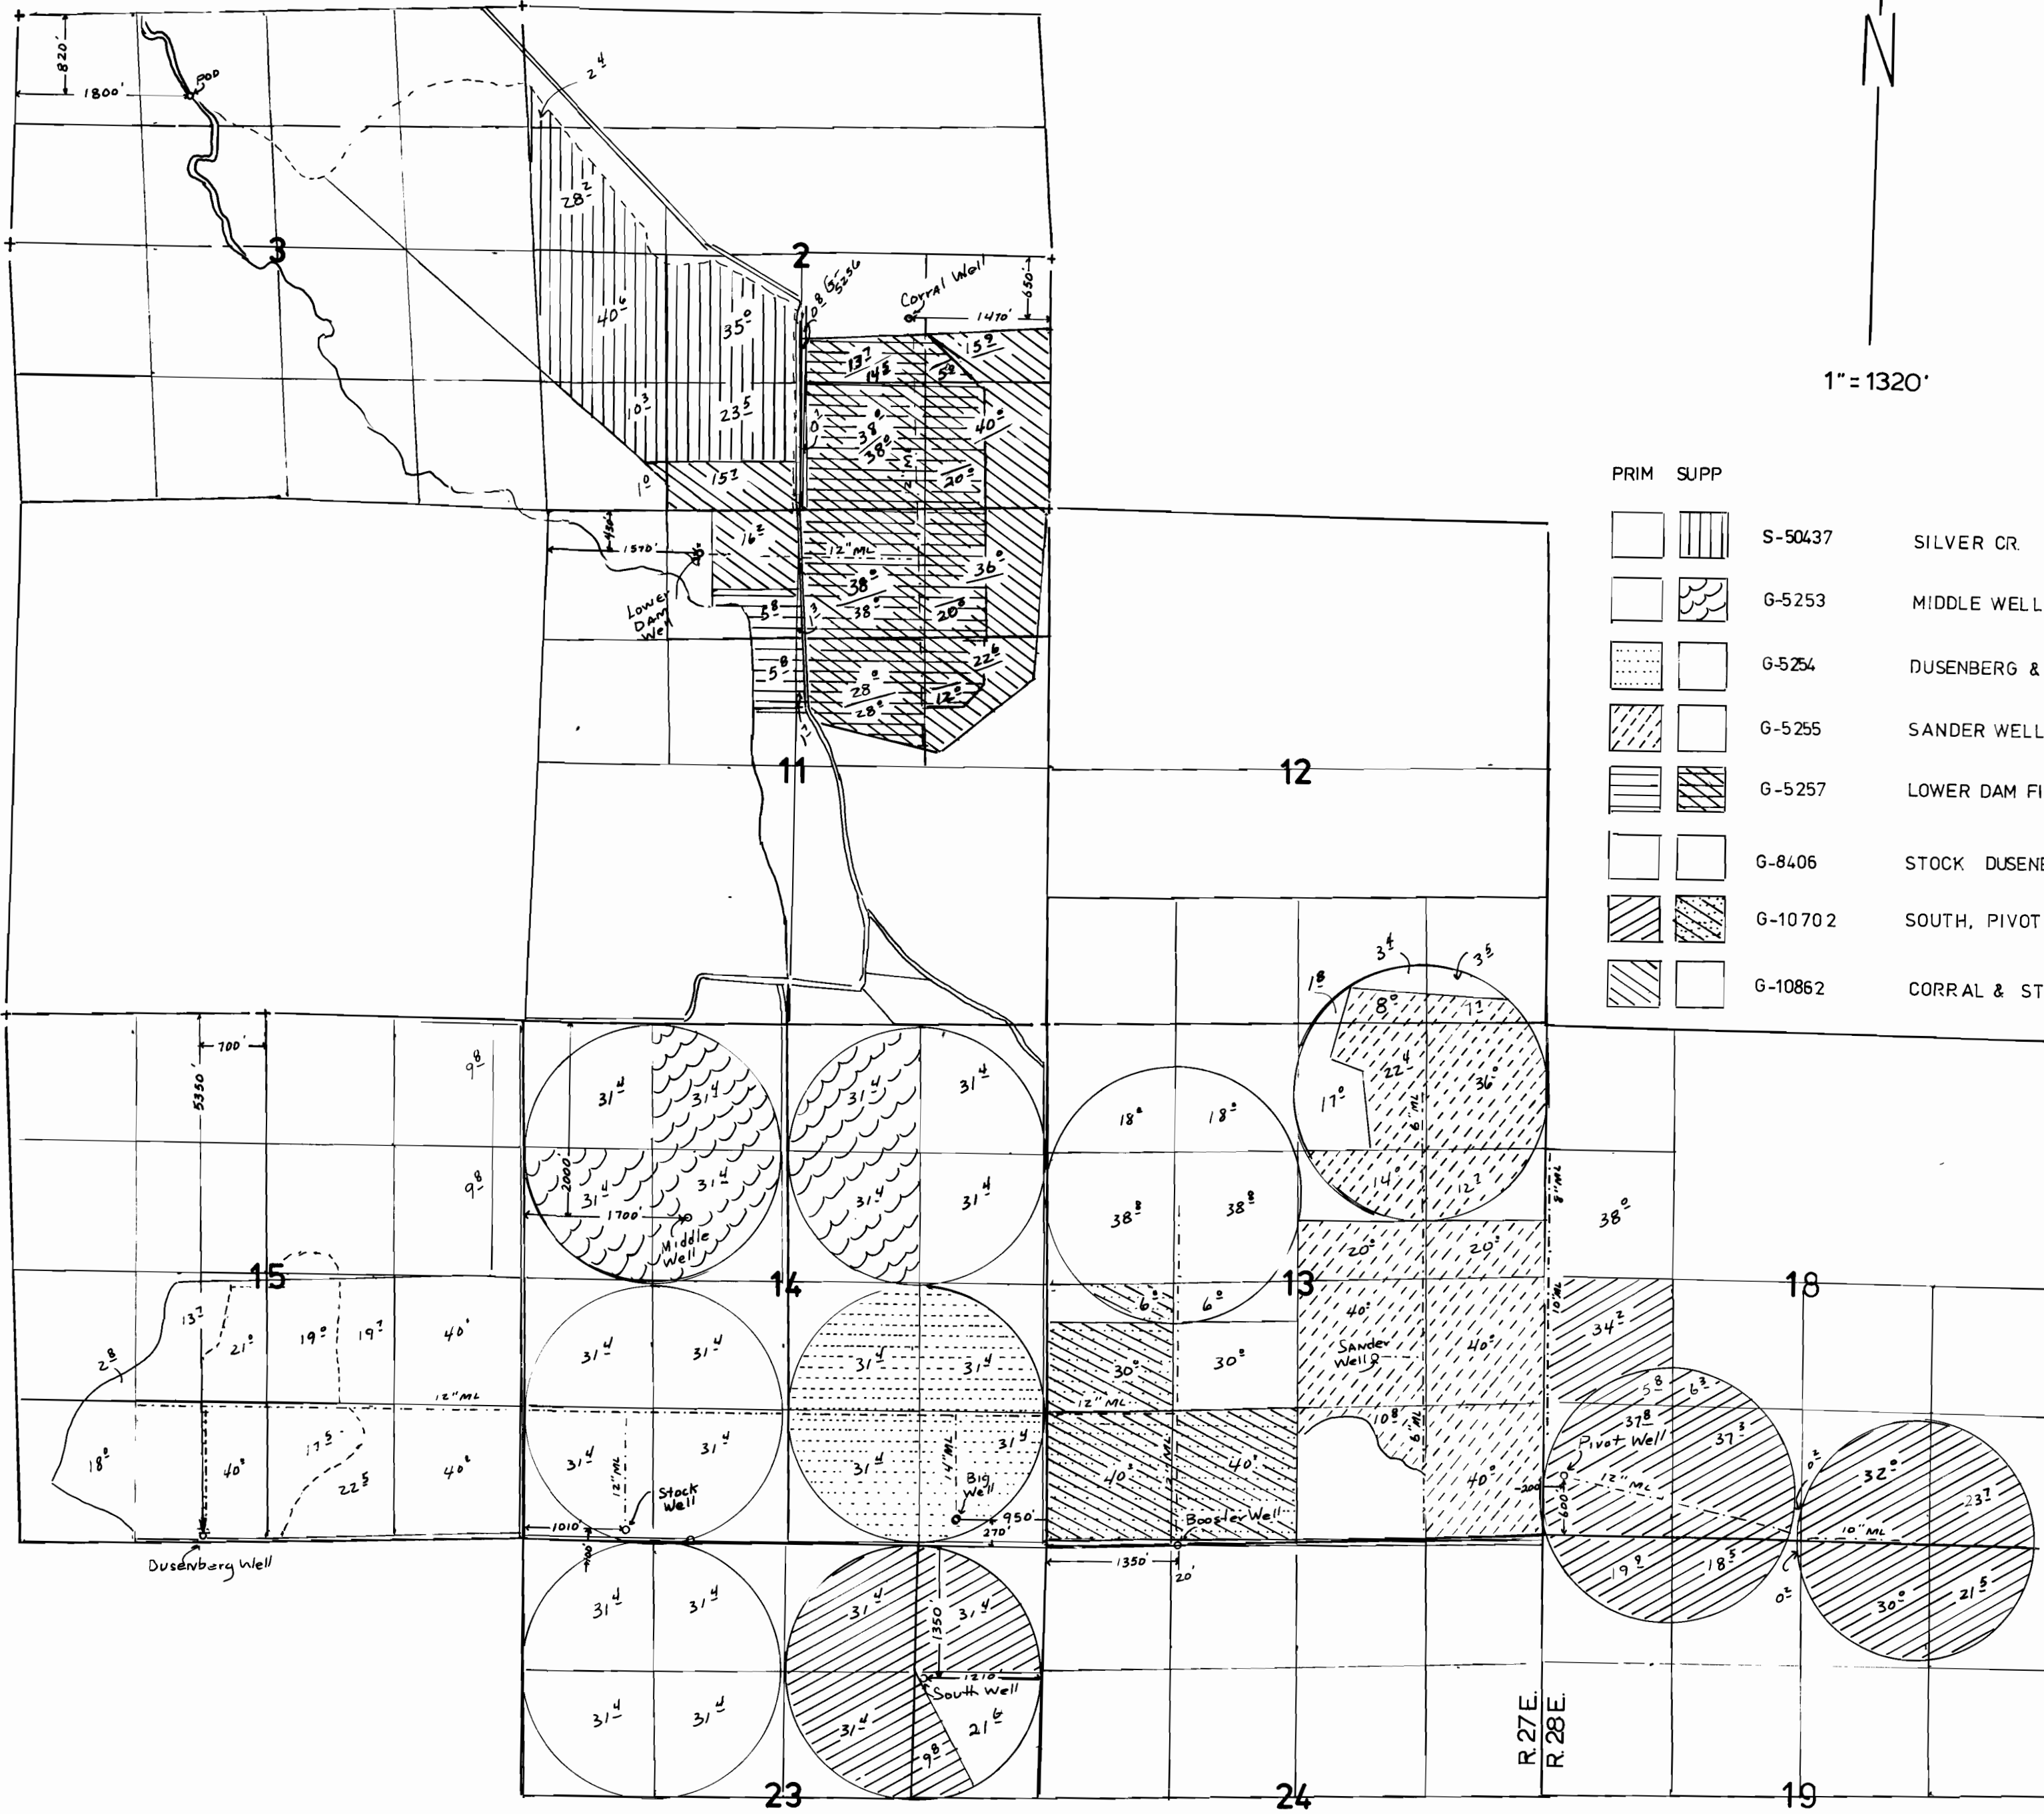

PRIM	SUPP	Well Number	Well Name
[Symbol]	[Symbol]	S-50437	SILVER CR
[Symbol]	[Symbol]	G-5253	MIDDLE WELL
[Symbol]	[Symbol]	G-5254	DUSENBERG & BIG
[Symbol]	[Symbol]	G-5255	SANDER WELL
[Symbol]	[Symbol]	G-5257	LOWER DAM FIELD WELL
[Symbol]	[Symbol]	G-8406	STOCK DUSENBERG & BIG WELLS
[Symbol]	[Symbol]	G-10702	SOUTH, PIVOT & BOOSTER
[Symbol]	[Symbol]	G-10862	CORRAL & STOCK WELLS

FINAL PROOF SURVEY  
UNDER

APPLICATION NO. S-65353 PERMIT NO. S-50437  
 G 6726 G 5253  
 G 6727 G 5254  
 G 6728 G 5255  
 G 6730 G 5257  
 G 8947 G 8406  
 G 11037 G 10702  
 G 11036 G 10862

IN THE NAME OF  
 DENNY LAND AND CATTLE COMPANY LLC  
 SURVEYED FEB. 25, 2000, BY J. MILLER

CGSU MAP # 0086

EF1 5V-145  
 NAPP 41025-1213-54  
 NAPP 41025-1211-102-R, 101R, 102R, 103R.  
 41025-279-142D, 179-132B, 132A.

J. Miller 12-18-2000

9800