


T.5S., R.3W., W.M

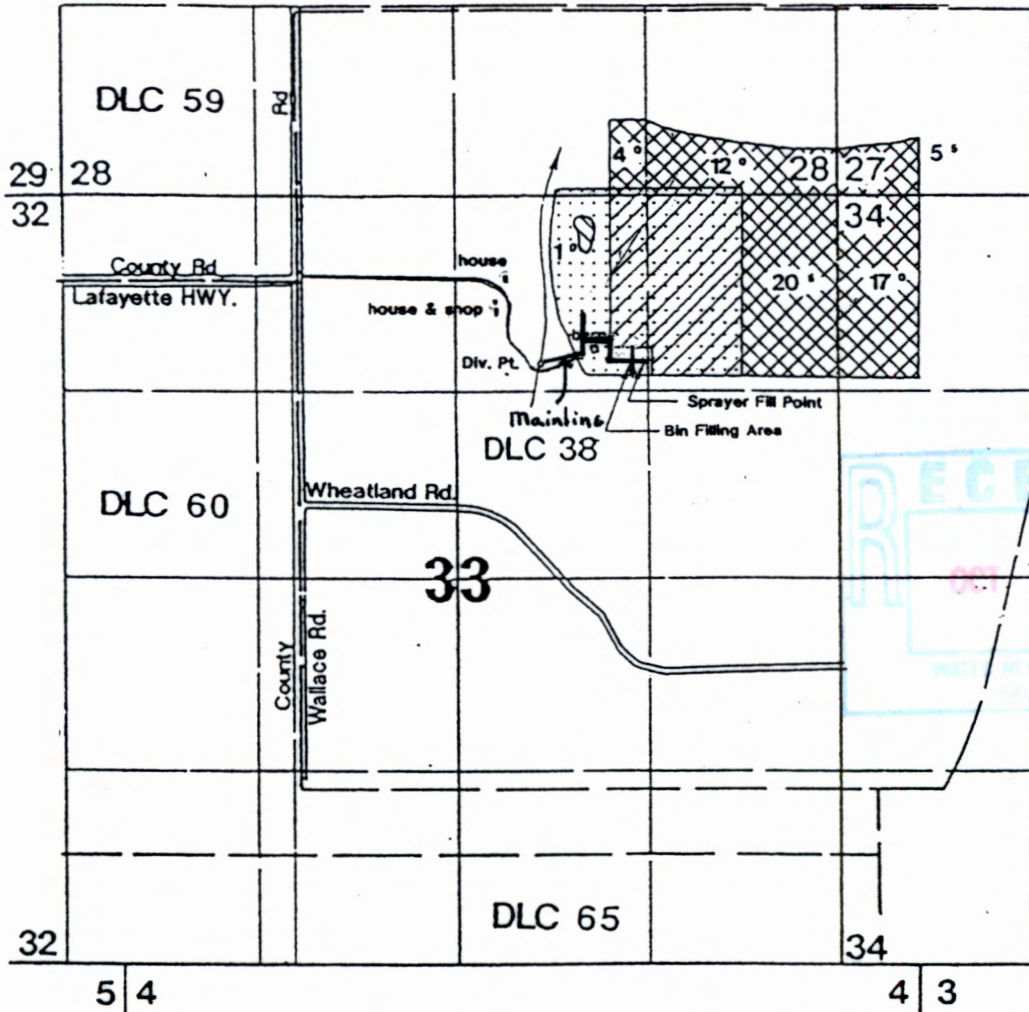


Diversion Point Location: 506 feet south and 1,660 feet east of the NE Corner of the Adam Matheny DLC No. 60 within the NW 1/4 of the NE 1/4, as projected in D. Matheny DLC 38, Section 33, T.5S., R.3W. WM.

Application S-71485
Permit S-51600

-  Irrigation Only
-  Irrigation and Spray
-  Spray Only
-  Irrigation Permit No. 17090

Scale: 1" = 1,320'

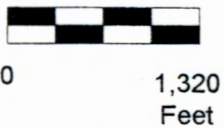

EXPIRATION DATE: 12/31/02



This map was prepared for the purpose of identifying the location of a water right only and is not intended to provide legal dimensions or location of property ownership lines.

Claim of Beneficial Use

Roy E. and Darlene S. Smith
T.5S. R.3W. Portions of Sec. 28, 27, 33, and 34

Pacific Hydro-Geology Inc.