


T.11S., R.29E.
T.11S., R.30E.

RECEIVED

SEP 16 2021

OWRD

T.11S., R.30E., W.M.

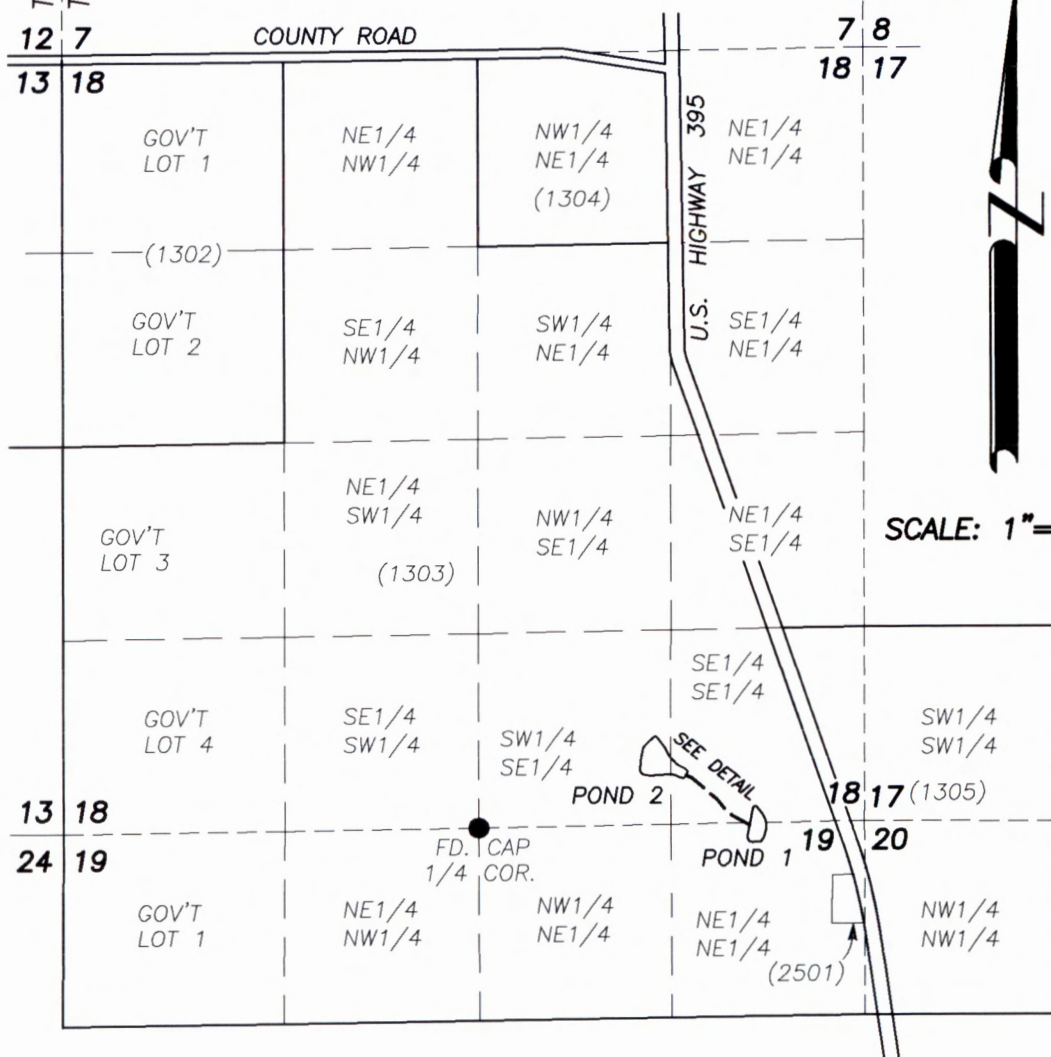

CLAIM OF BENEFICIAL USE MAP

UNDER

APPLICATION R-88022

PERMIT R-15149

IN NAME OF

ROY VARDANEGA

○ POND 1: CENTERLINE OF DAM AT OUTLET PIPE IS 20 FT. NORTH & 1855 FT. EAST FROM THE S1/4 CORNER SECTION 18.

■ MEASURING DEVICE: STAFF GAUGE IN POND BEARS S.80°E., 35 FT. FROM CENTERLINE OF DAM AT OUTLET PIPE.

△ POND 2: POD: A SPRING 380 FT. NORTH & 1440 FT. EAST FROM THE S1/4 CORNER SECTIONS 18.


○ CENTERLINE OF DAM AT OUTLET PIPE IS 540 FT. NORTH & 1130 FT. EAST FROM THE S1/4 CORNER SECTION 18.
■ MEASURING DEVICE: STAFF GAUGE IN POND BEARS S.60°E., 22 FT. FROM THE CENTERLINE OF DAM AT OUTLET PIPE.

--- PIPELINE

() TAX LOT

PREPARED BY
ROBERT D. BAGETT, PLS, CWRE
217 N. CANYON BLVD.
JOHN DAY, OR 97845

MAY 22, 2021

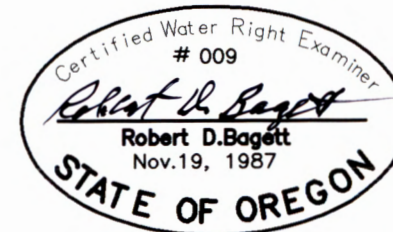

RENEWES 12/31/2021

DISCLAIMER: THIS MAP IS NOT INTENDED TO PROVIDE LEGAL DIMENSIONS OR LOCATIONS OF PROPERTY OWNERSHIP LINES.

