


Claim of Beneficial Use

Permit S-52620, Application S-71647

A Water Right held by Hillsboro Landfill Inc.
Washington County

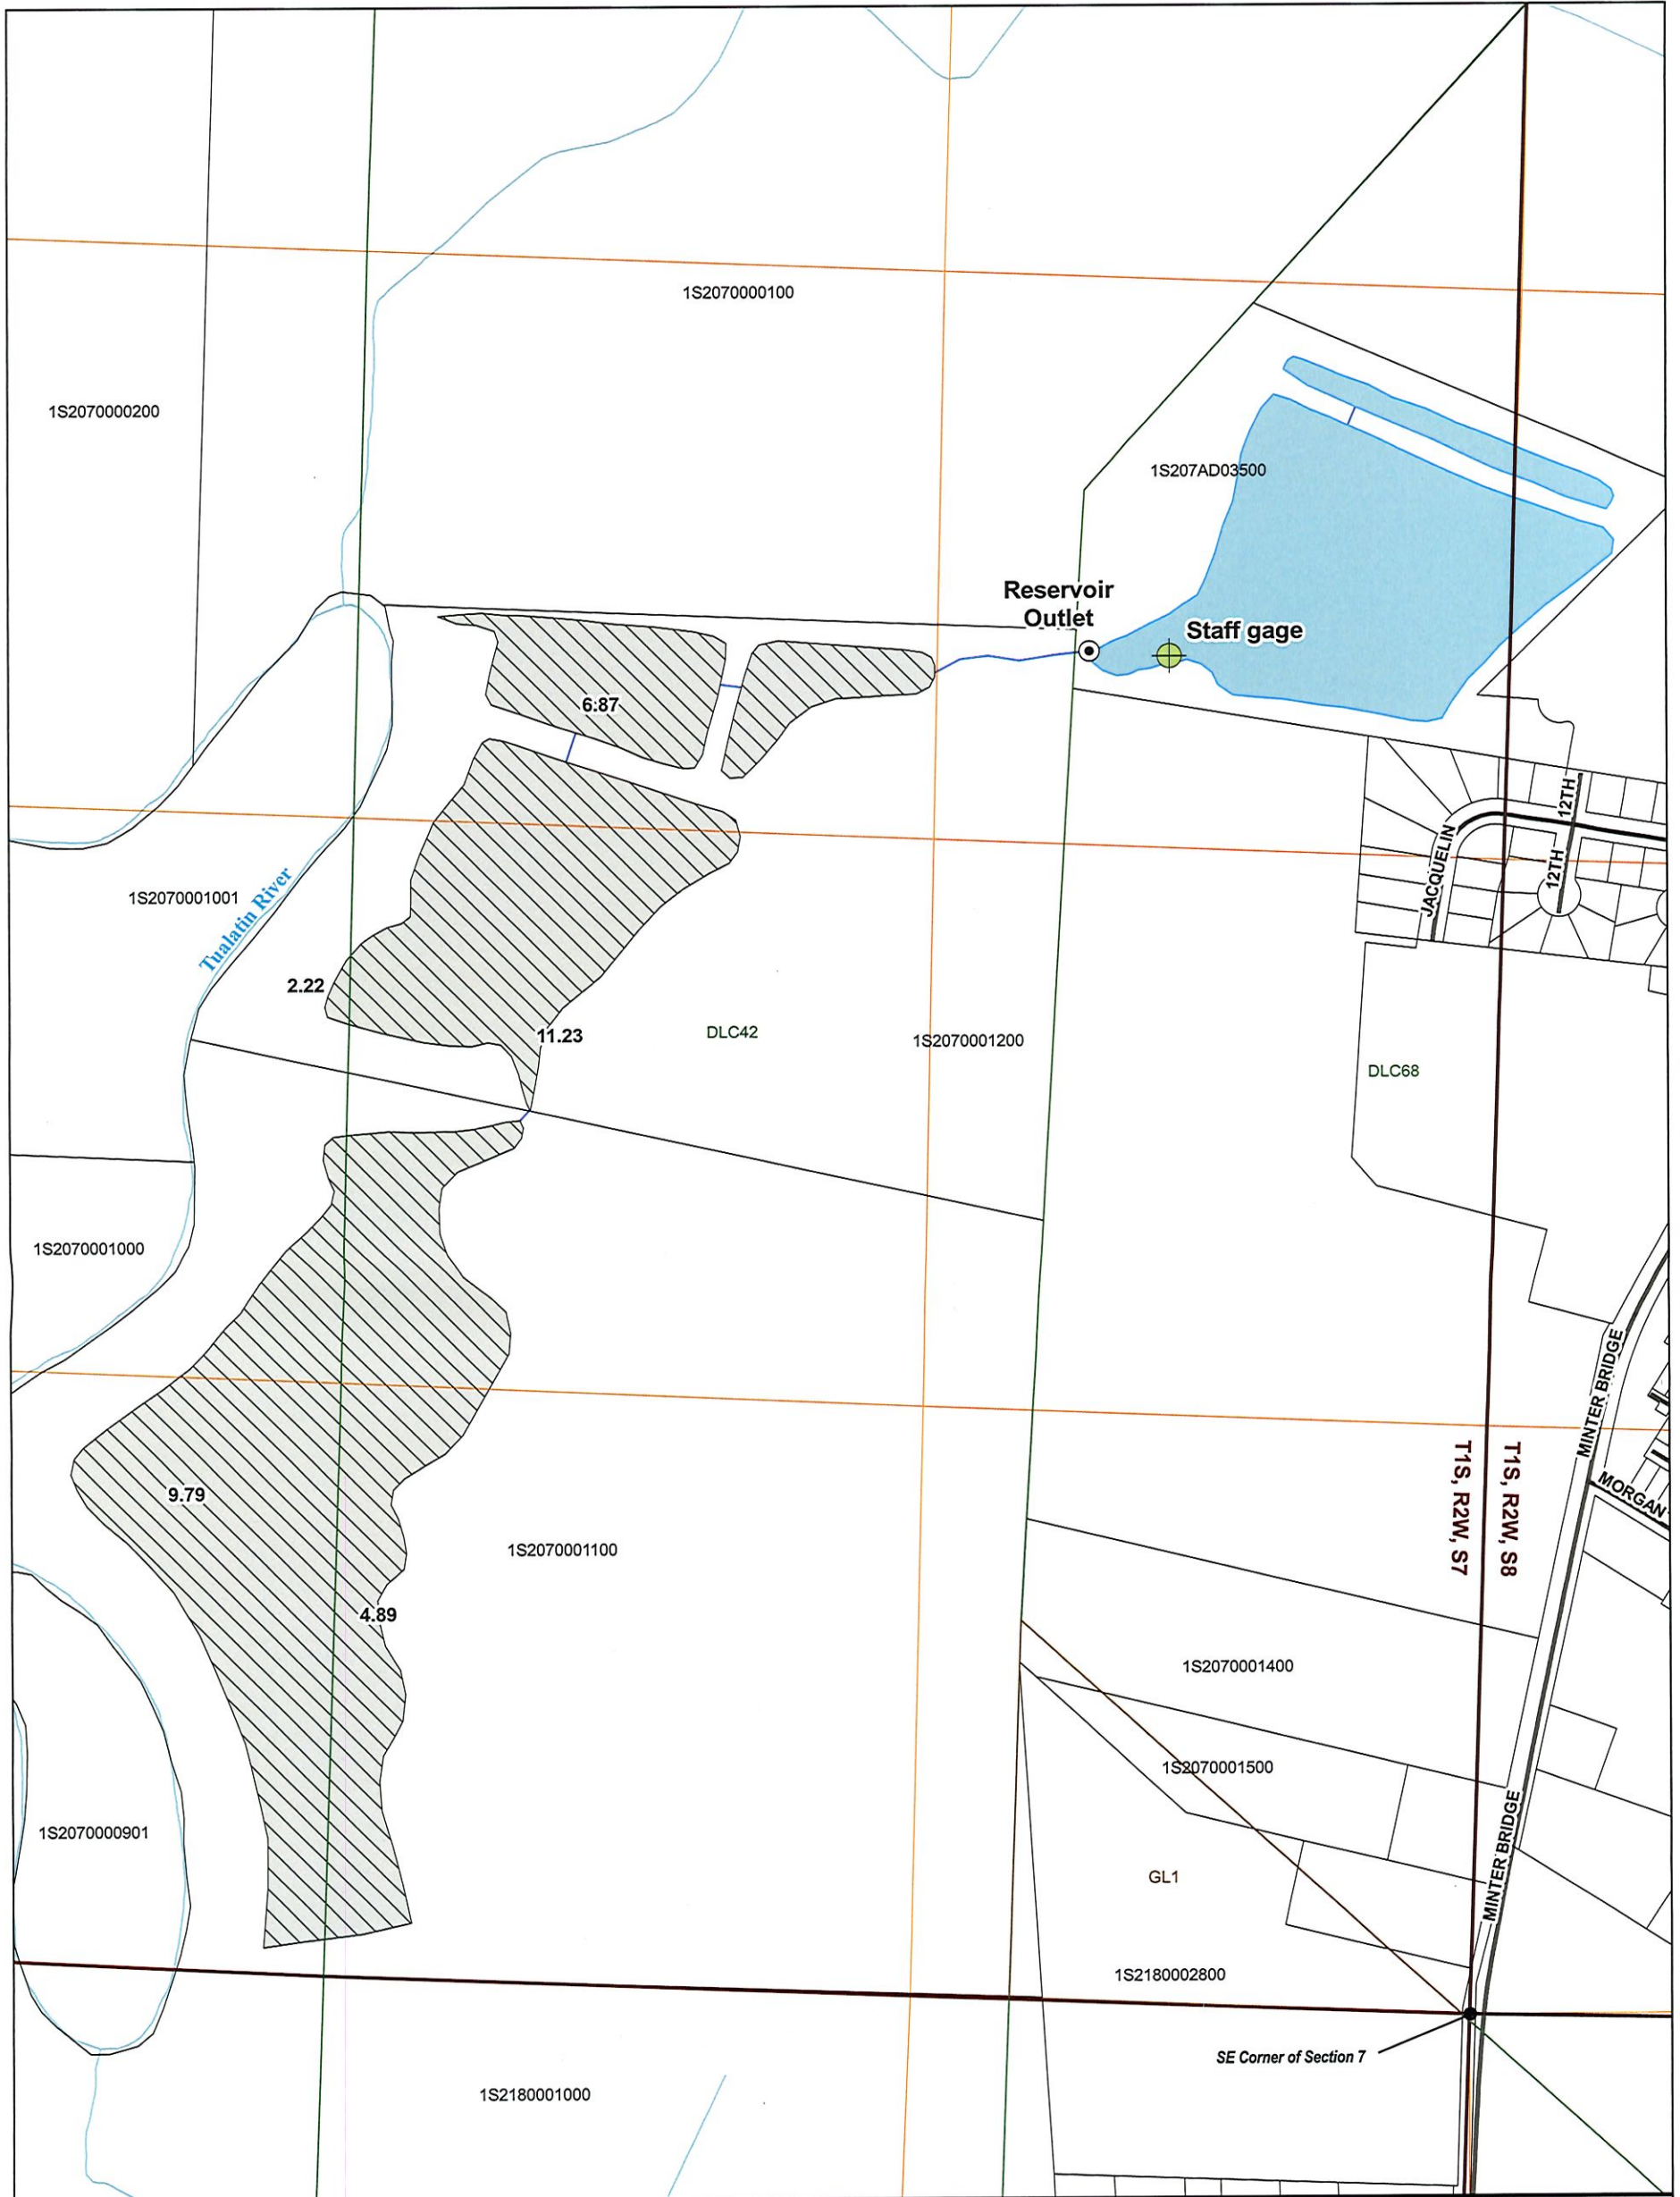


Project\Waste_Management\1_GIS\1_SWR_Files\1_SWR_Maps\Waste_Management_Map.aprx

LEGEND

-  Point of Diversion
-  Place of Use
-  Conveyance Pipeline
-  Reservoir (Permit R-11928)
-  Streams
-  Tax Lots
-  Roads
-  Sections
-  QQ
-  Donation Land Claim
-  Government Lot

POD Location Description

Reservoir Outlet
Located 3,169 feet North and 982 feet West from SE corner of Section 7, Township 1 South, Range 2 West, W.M.

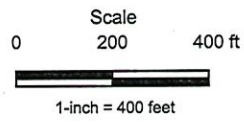

Date: 10/7/2023
Data Sources: BLM, OWRD, USGS, Metro.
Disclaimer: This map is not intended to provide legal dimensions or locations of property ownership lines.

RECEIVED
OCT 29 2023
OWRD



RENEWS: 12-31-2024

CWRE Seal and Signature

