

SEC. 8, T.6S, R.2E, W.M.

RECEIVED


FEB 24 1998

WATER RESOURCES DEPT
SALEM, OREGON

N



SCALE
1"=400'

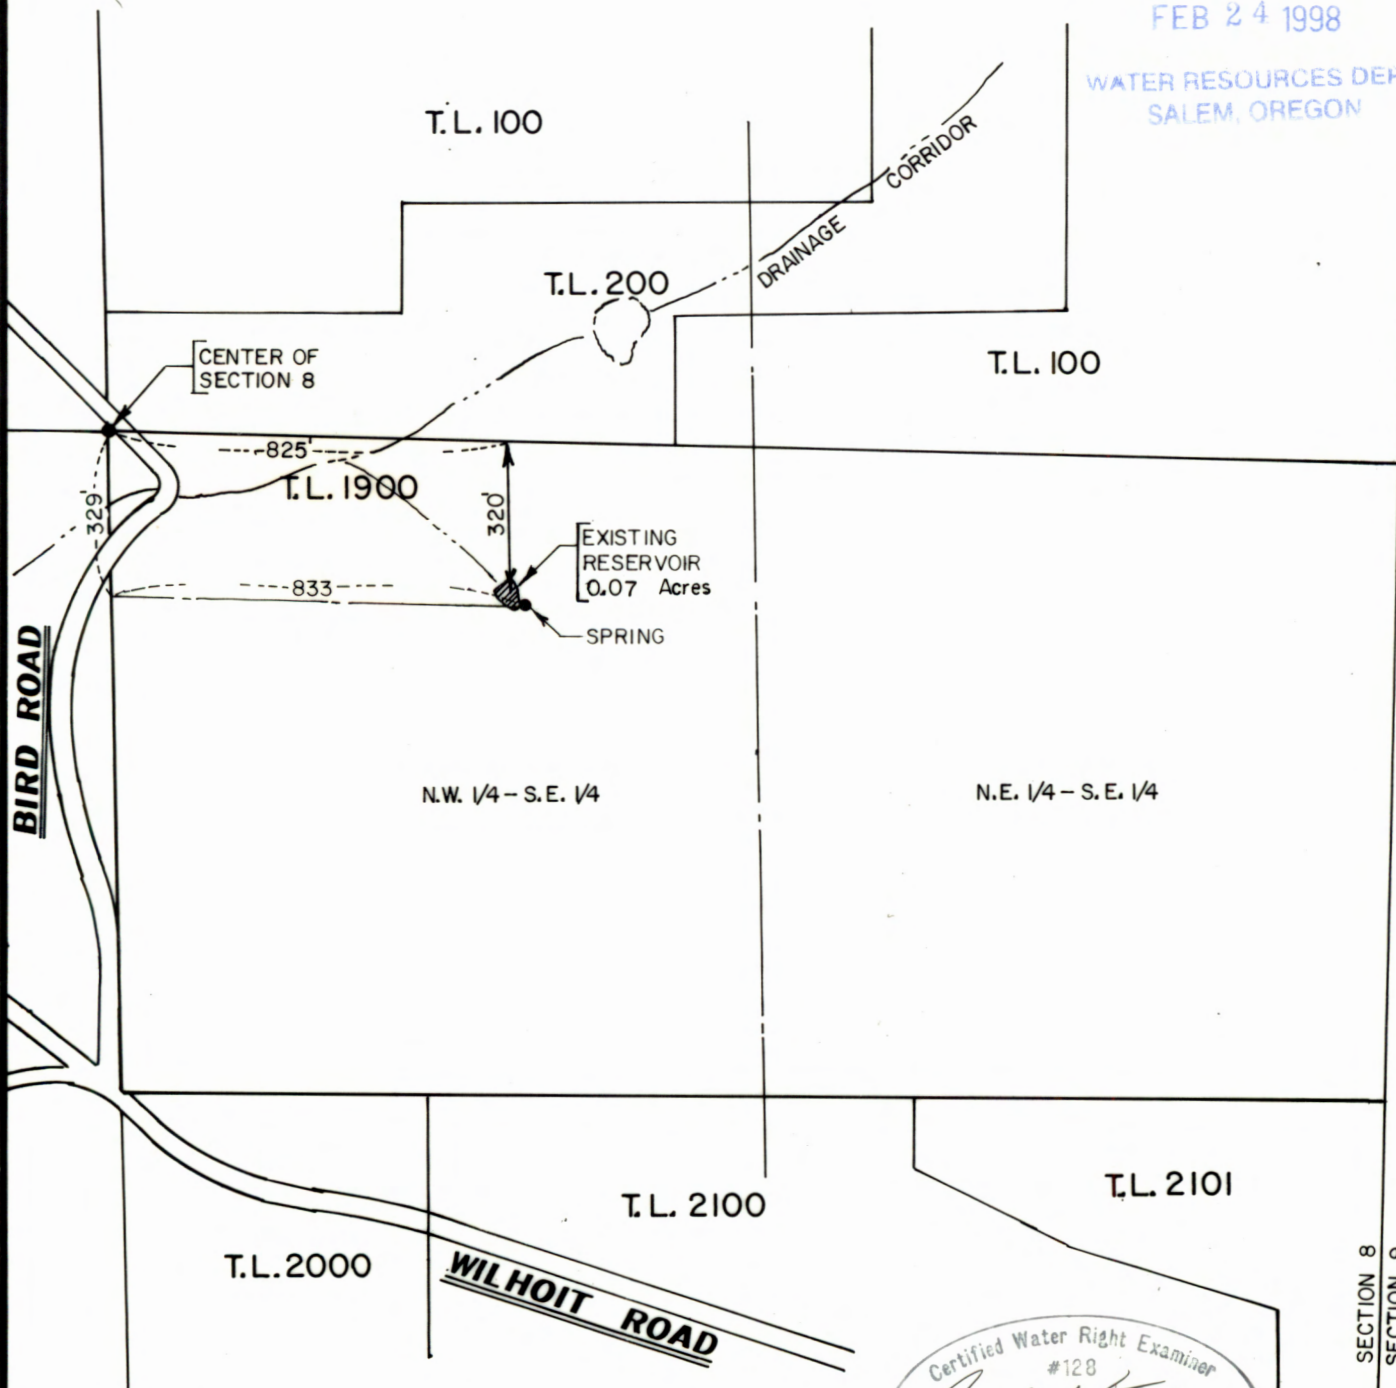


**RESERVOIR
FINAL PROOF SURVEY
FOR**

MILDRED HICKS

APPLICATION NO. R-72388

PERMIT NO. R-11485

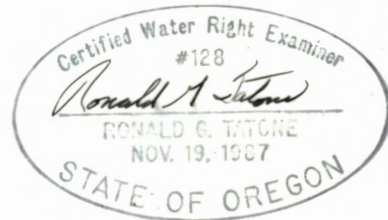

ZTec ENGINEERS, INC.

3737 S.E. 8TH AVE., PORTLAND, OR. 97202

PHONE: (503) 235-8795

FAX: (503) 233-7889