
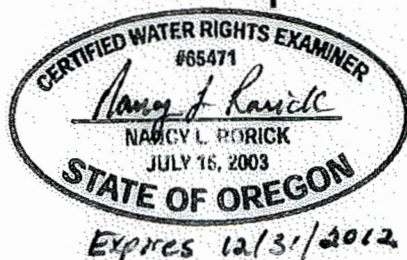


T2S, R5W, Sections 5 and 6, Willamette Meridian

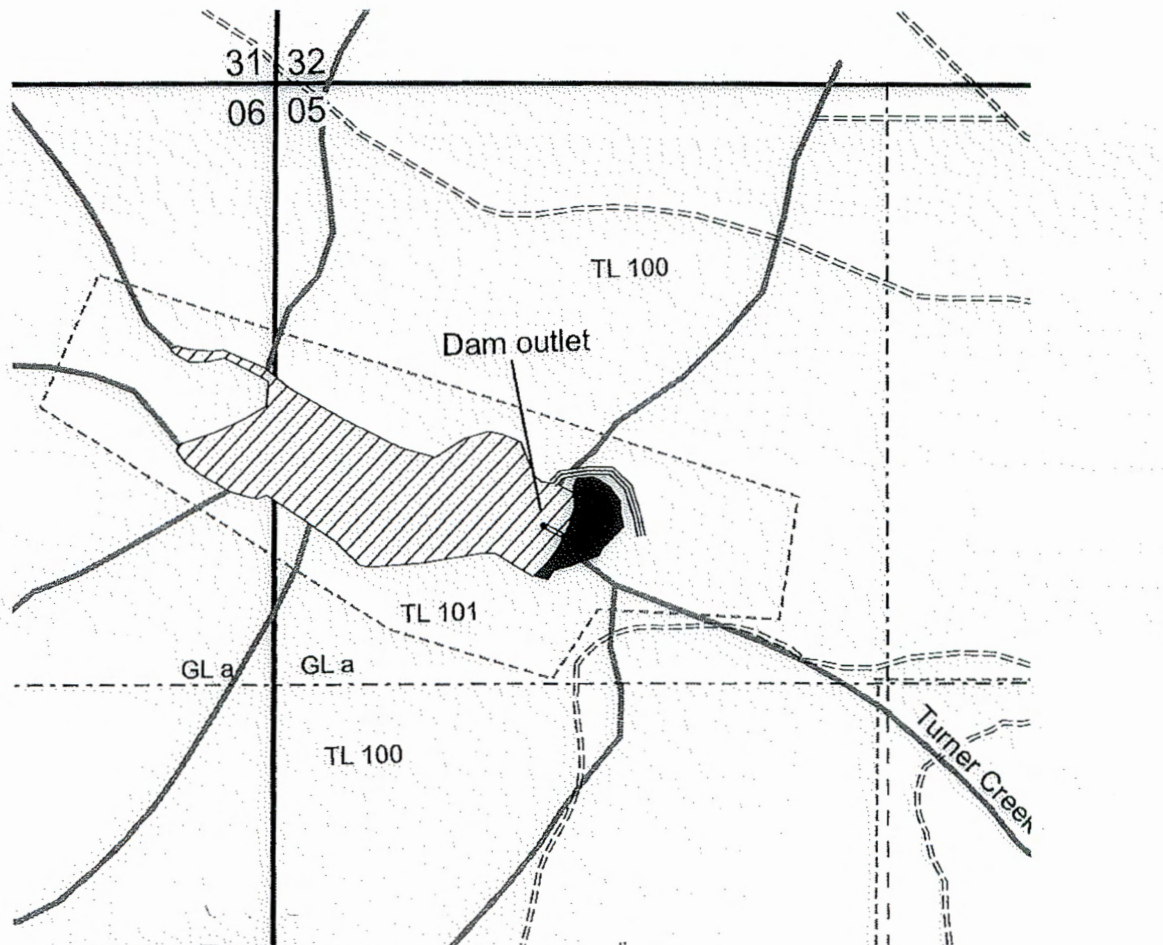

0 200 400
Feet

1 inch = 400 feet

Dam outlet is 600 feet east and 970 feet south of the northwest corner of section 5.

- Dam
- Turner Creek Reservoir
- Spillway
- Tax lot lines
- Section Lines
- Government Lot Line
- 1/4 1/4 Section Line
- Streams
- Unimproved roads

This map was prepared for the purpose of identifying the location of a water right only and is not intended to provide legal dimensions or location of property ownership lines.

Nancy Rorick Consulting

Claim of Beneficial Use Map
City of Yamhill
Tax lot 101
Permit R7245 and Application R57026