


RECEIVED  
 OCT 15 2019  
 OWRD

TOWNSHIP 19 SOUTH, RANGE 12 WEST, W.M.

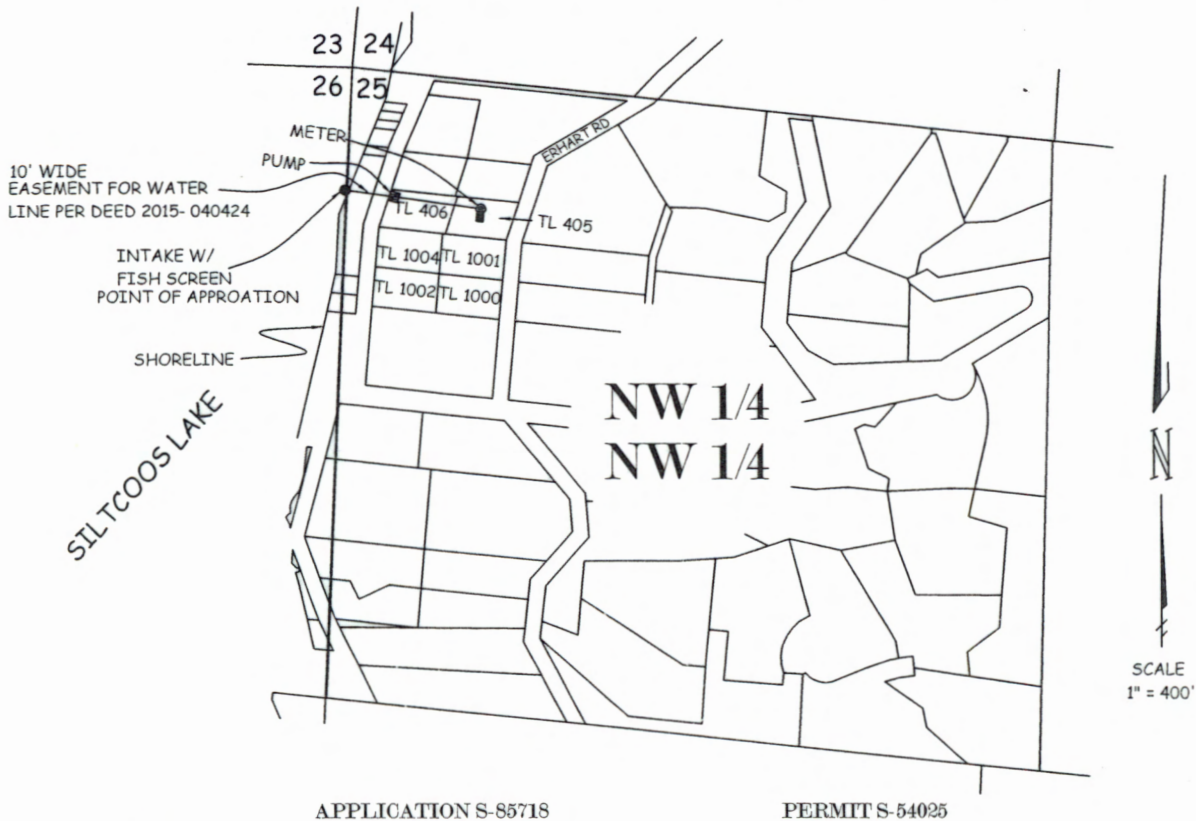

APPLICATION S-85718

PERMIT S-54025

LEGEND

- DENOTES HOUSE LOCATION
- DENOTES POINT OF APPROPRIATION LOCATION  
 255' SOUTH & 15' WEST OF NW COR. SEC. 25  
 DENOTES POINT OF APPROPRIATION LOCATION
- DENOTES PUMP LOCATION  
 270' SOUTH & 85' EAST OF NW COR. SEC. 25  
 DENOTES POINT OF APPROPRIATION LOCATION
- DENOTES PUMP LOCATION  
 295' SOUTH & 264' EAST OF NW COR. SEC. 25  
 DENOTES POINT OF APPROPRIATION LOCATION

SEE TAX MAP NO. 19-12-25-22 FOR TAX LOT INFO.

THIS MAP WAS PREPARED FOR THE PURPOSE OF IDENTIFYING THE LOCATION OF THE WATER RIGHT ONLY. IT IS NOT INTENDED TO PROVIDE DIMENSIONS OR LOCATION OF PROPERTY OWNERSHIP LINES.

FINAL PROOF SURVEY  
 FOR  
 McFarland Trust  
 83418 ERHART ROAD  
 FLORENCE, OR. 97439

BY  
 H. TIMOTHY FASSBENDER, PLS, CWRE  
 2896 SARAH LANE  
 EUGENE, OR. 97408  
 AUGUST 20, 2019

