

RECEIVED
OCT 17 2023


OWRD

NW 1/4 of the NE 1/4 SECTION 22
T3S, R4E of the WM
CLACKAMAS COUNTY, OREGON

RECEIVED

JAN 18 2006

WATER RESOURCES DEPT
SALEM, OREGON

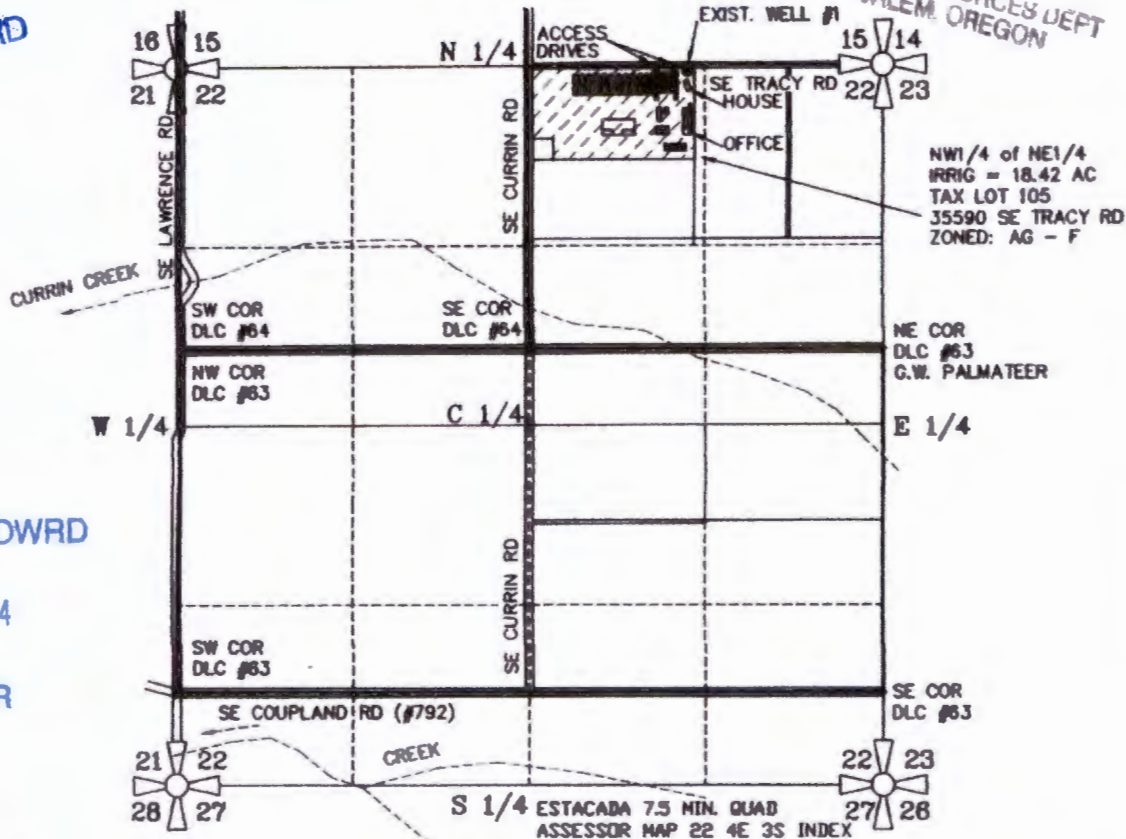

RECEIVED BY OWRD


NOV 05 2014

SALEM, OR

CORPORATE
BOUNDARY LINE
DONATION LAND
CLAIM (DLC #)

SEC	1/4 1/4	ACRES IRRIGATED	CFS (GPM)
22	NW NE	18.42 ACRES IN-GROUND GREENHOUSES & DOMESTIC EXPANDED	0.100 CFS (45 GPM)
TOTAL		IRRIGATED & OTHER USES	0.10 CFS (45 GPM)


IRRIG. WELL #1 is located 47 FEET SOUTH and 1453.58 FEET WEST
of the NORTHEAST CORNER of SECTION 22. WELL IS LOCATED IN
the NORTHWEST 1/4 of the NORTHEAST 1/4 of SECTION 22, T3S,
RANGE 4 EAST of the WM, CLACKAMAS COUNTY, OREGON

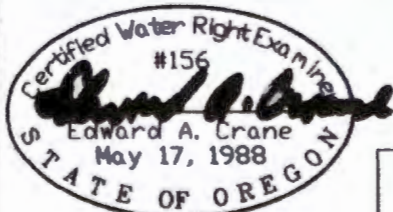

Renewal 12/31/2005

Signed *Edward A. Crane*

SURVEYED DEC. 14, 2005
BY EDWARD A. CRANE, CWRE

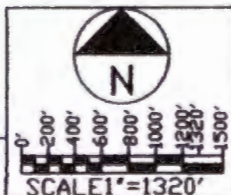

PREPARATION OF THIS MAP WAS FOR THE PURPOSE
OF IDENTIFYING THE LOCATION OF THE WATER RIGHTS
ONLY AND HAS NO INTENT TO PROVIDE DIMENSIONS
OR LOCATION OF PROPERTY OWNERSHIP LINES.

FINAL PROOF SURVEY
GROUNDWATER PERMIT G-15381

PREPARED BY EDWARD A. CRANE, CWRE

DATE DEC. 2005		CRANE ENGINEERING & SURVEYING, INC. 13755 SE 119TH DRIVE CLACKAMAS, OREGON 97015 OFFICE: 503-698-3890 FAX NO: 503-698-3861 CELL TEL: 503-679-3253 E-MAIL: ECES@VERIZON.NET	APPLICATION FOR PERMIT NUMBER G-15187 PERMIT NUMBER G-15381 IN THE NAME OF: RENE' J. HUURMAN - NW BULB & PERENNIAL 35590 TRACY ROAD (TEL: 503-630-4301) ESTACADA, OR 97023 (FAX: 503-630-4368)	SHEET 1/2
PROJECT NO. 527-001				

RECEIVED BY OWRD

NOV 05 2014


SALEM, OR

NW 1/4 of the NE 1/4 SECTION 22
T3S, R4E of the WM
CLACKAMAS COUNTY, OREGON

RECEIVED

OCT 17 2023

OWRD

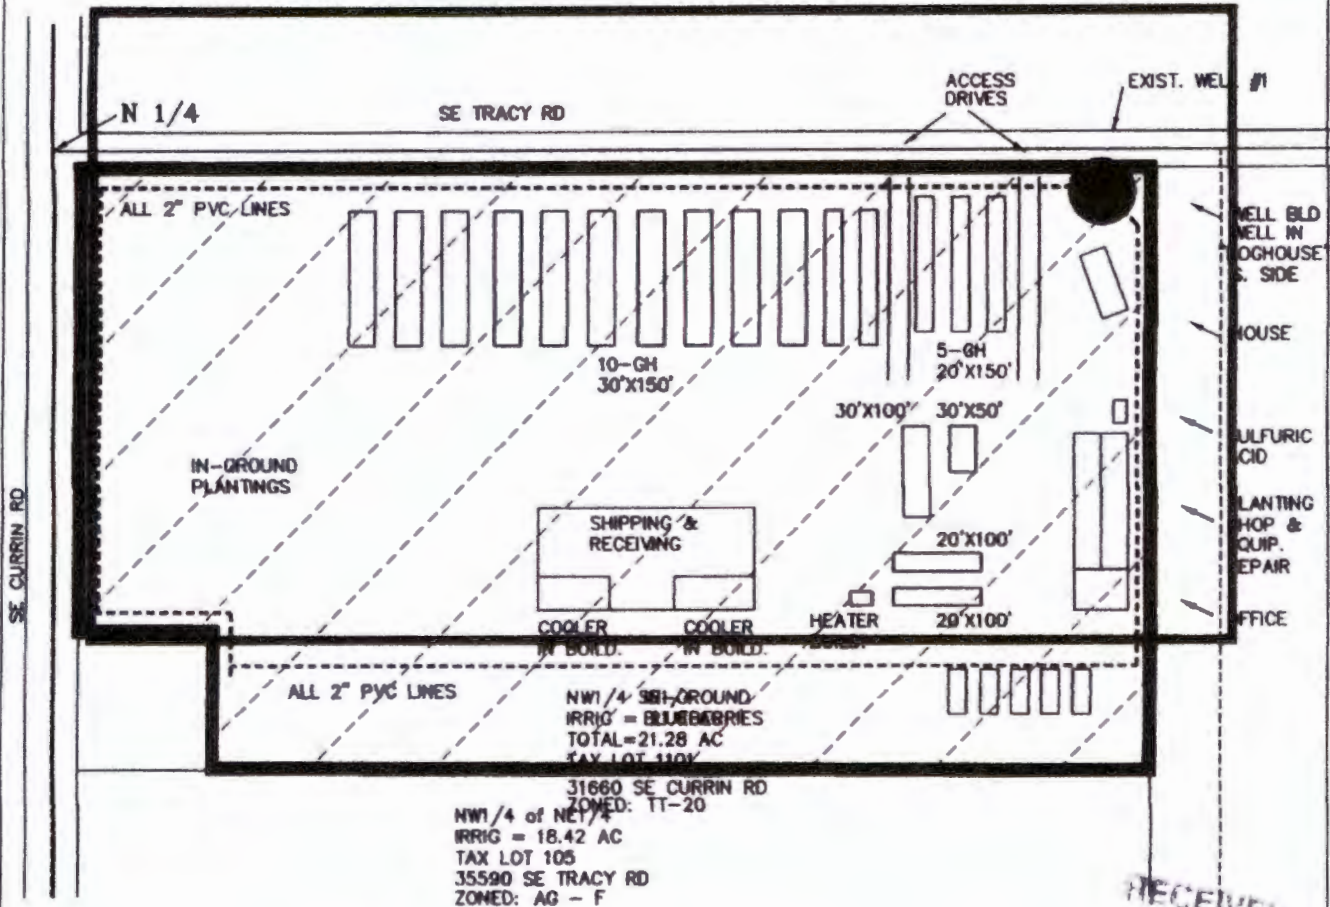


Certified Water Right Examiner
#156
Edward A. Crane
Edward A. Crane
May 17, 1988
STATE OF OREGON

Renewal 12/31/2005

Signed *Edward A. Crane*

SURVEYED DEC. 14, 2005
BY EDWARD A. CRANE, CWRE

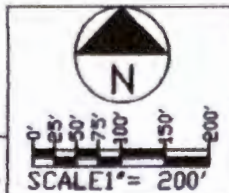

PREPARATION OF THIS MAP WAS FOR THE PURPOSE
OF IDENTIFYING THE LOCATION OF THE WATER RIGHTS
ONLY AND HAS NO INTENT TO PROVIDE DIMENSIONS
OR LOCATION OF PROPERTY OWNERSHIP LINES.

FINAL PROOF SURVEY GROUNDWATER PERMIT G-15381

PREPARED BY EDWARD A. CRANE, CWRE

RECEIVED
JAN 11 2006
WATER RESOURCES DEPT
SALEM, OREGON

DATE

DEC. 2005

PROJECT NO.

527-001



**CRANE ENGINEERING
& SURVEYING, INC.**

13755 SE 119TH DRIVE
CLACKAMAS, OREGON 97015

OFFICE: 503-698-3890
FAX NO: 503-698-3861
CELL TEL: 503-679-3253
E-MAIL: ECES@VERIZON.NET

APPLICATION FOR PERMIT NUMBER G-15187

PERMIT NUMBER G-15381 IN THE NAME OF:

RENE' J. HUURMAN - NW BULB & PERENNIAL
35590 TRACY ROAD (TEL: 503-630-4301)
ESTACADA, OR 97023 (FAX: 503-630-4368)

SHEET

2/2