


Application for Permanent Water Right Transfer Certificate 51171 REMAINING Lands


Township 2 South, Range 1 West (W.M.)

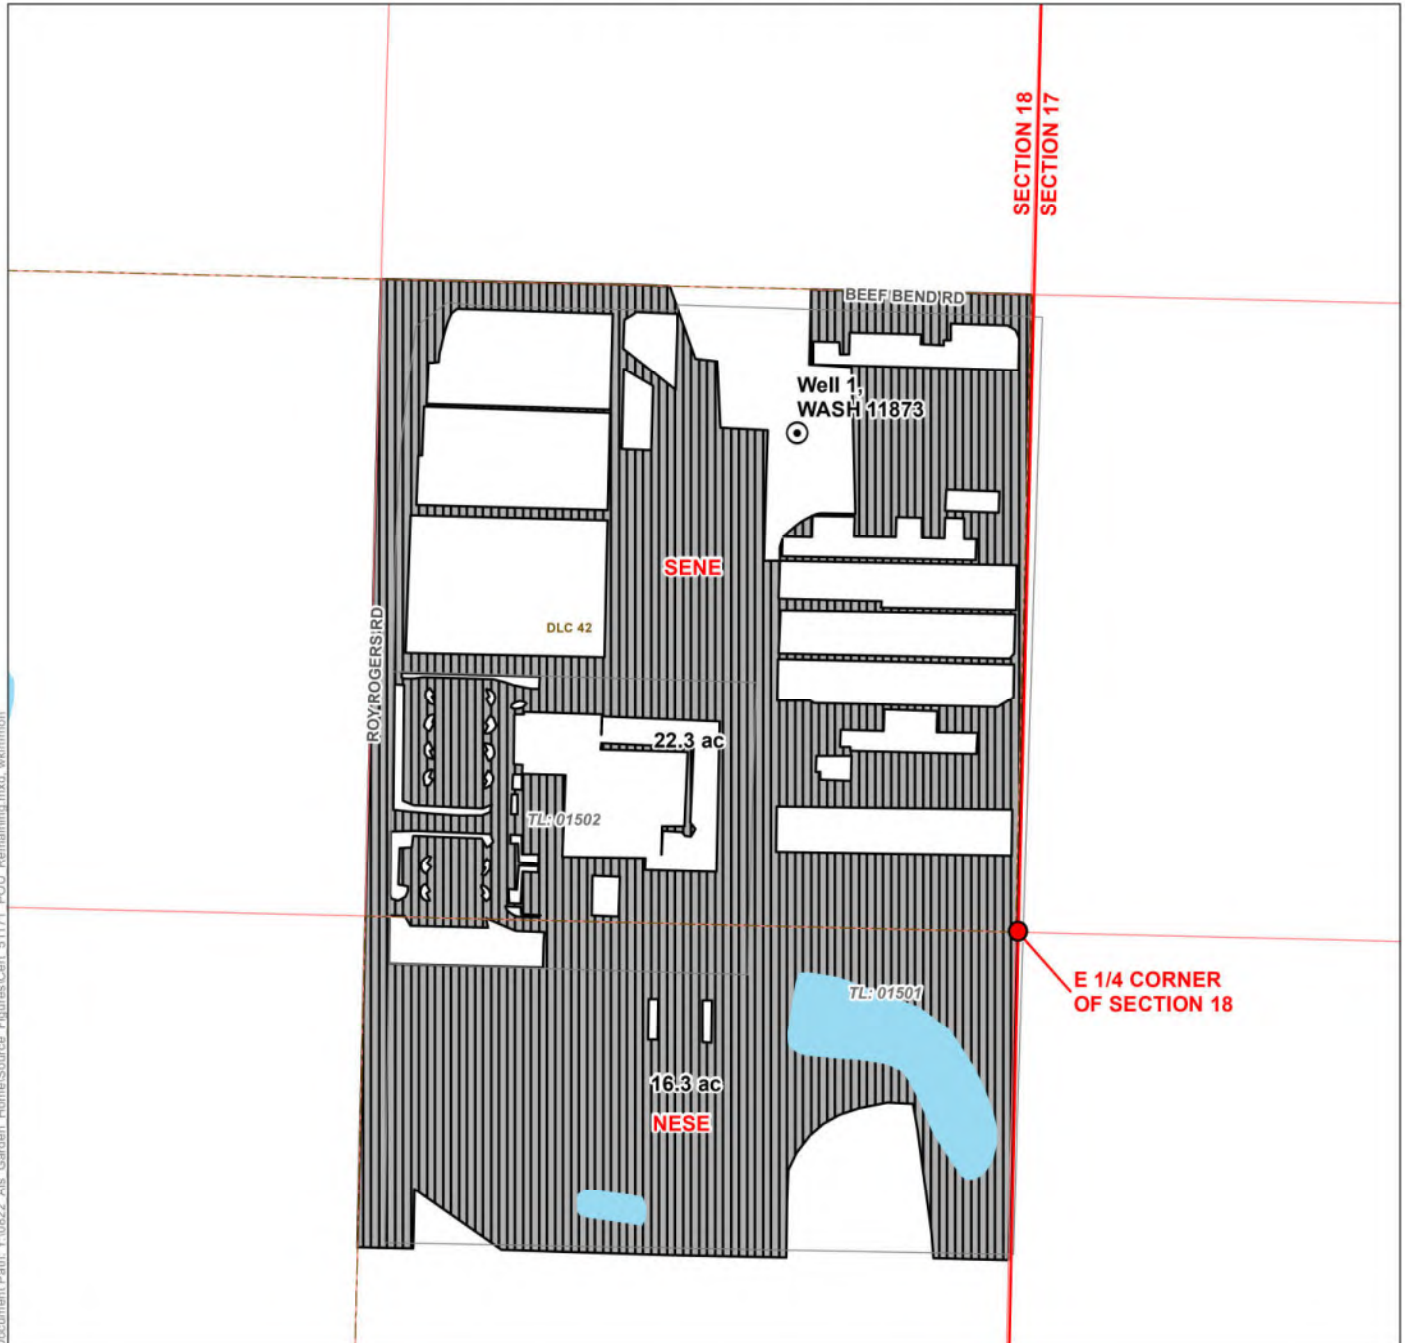

LEGEND

- Authorized Point of Appropriation (POA)
- Tax Lot
- Remaining Lands
- Railroad
- Government Lot (GL)
- Watercourse
- Waterbody

Certified Water Rights Examiner Stamp

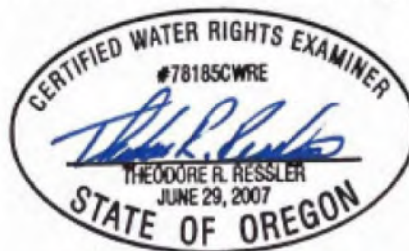

DISCLAIMER

This map was prepared for the purpose of identifying the location of a water right only and it is not intended to provide legal dimensions or location of property ownership lines.


MAP NOTES

Date: January 27, 2022
Data Sources: BLM, OWRD, Metro, ESRI


POA LOCATION DESCRIPTION

Well 1, WASH 11873
Located 1,020 feet North and 480 feet West from the E 1/4 corner of Section 18, Township 2 South, Range 1 West (W.M.)

RENEWED: 12-31-2024

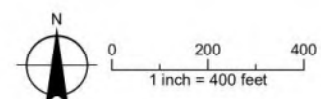

T. 2S.R.1W.W.M.

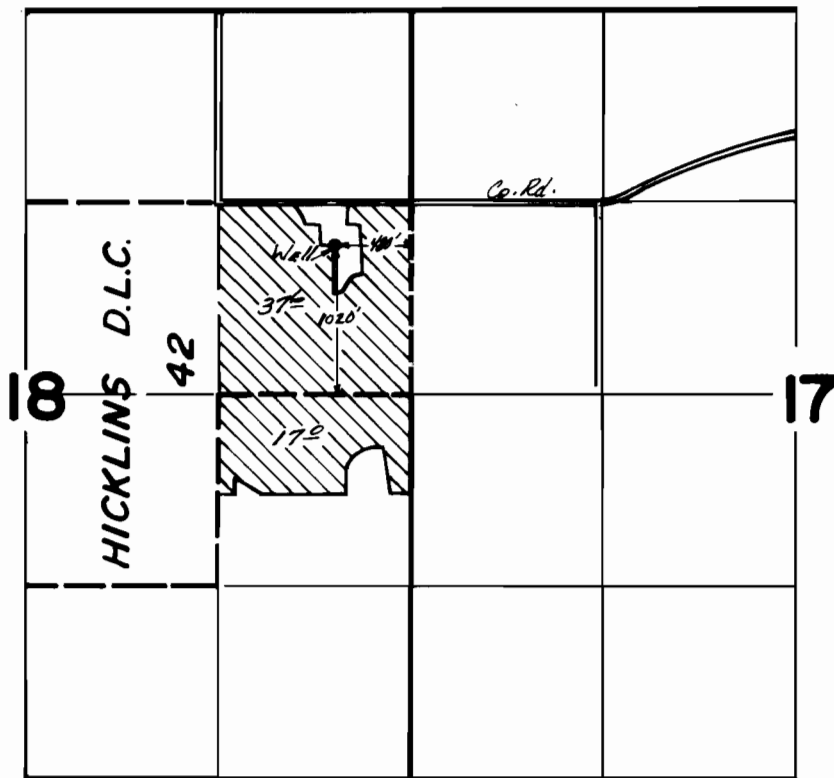

FINAL PROOF SURVEY
UNDER

Application No. G-5501 Permit No. G-5476
IN NAME OF

Porter Walton Co., Inc.

Surveyed July 24 1978, by R.G. Mucken