



Claim of Beneficial Use - Cala Farms Application G-16930, Permit G-16413



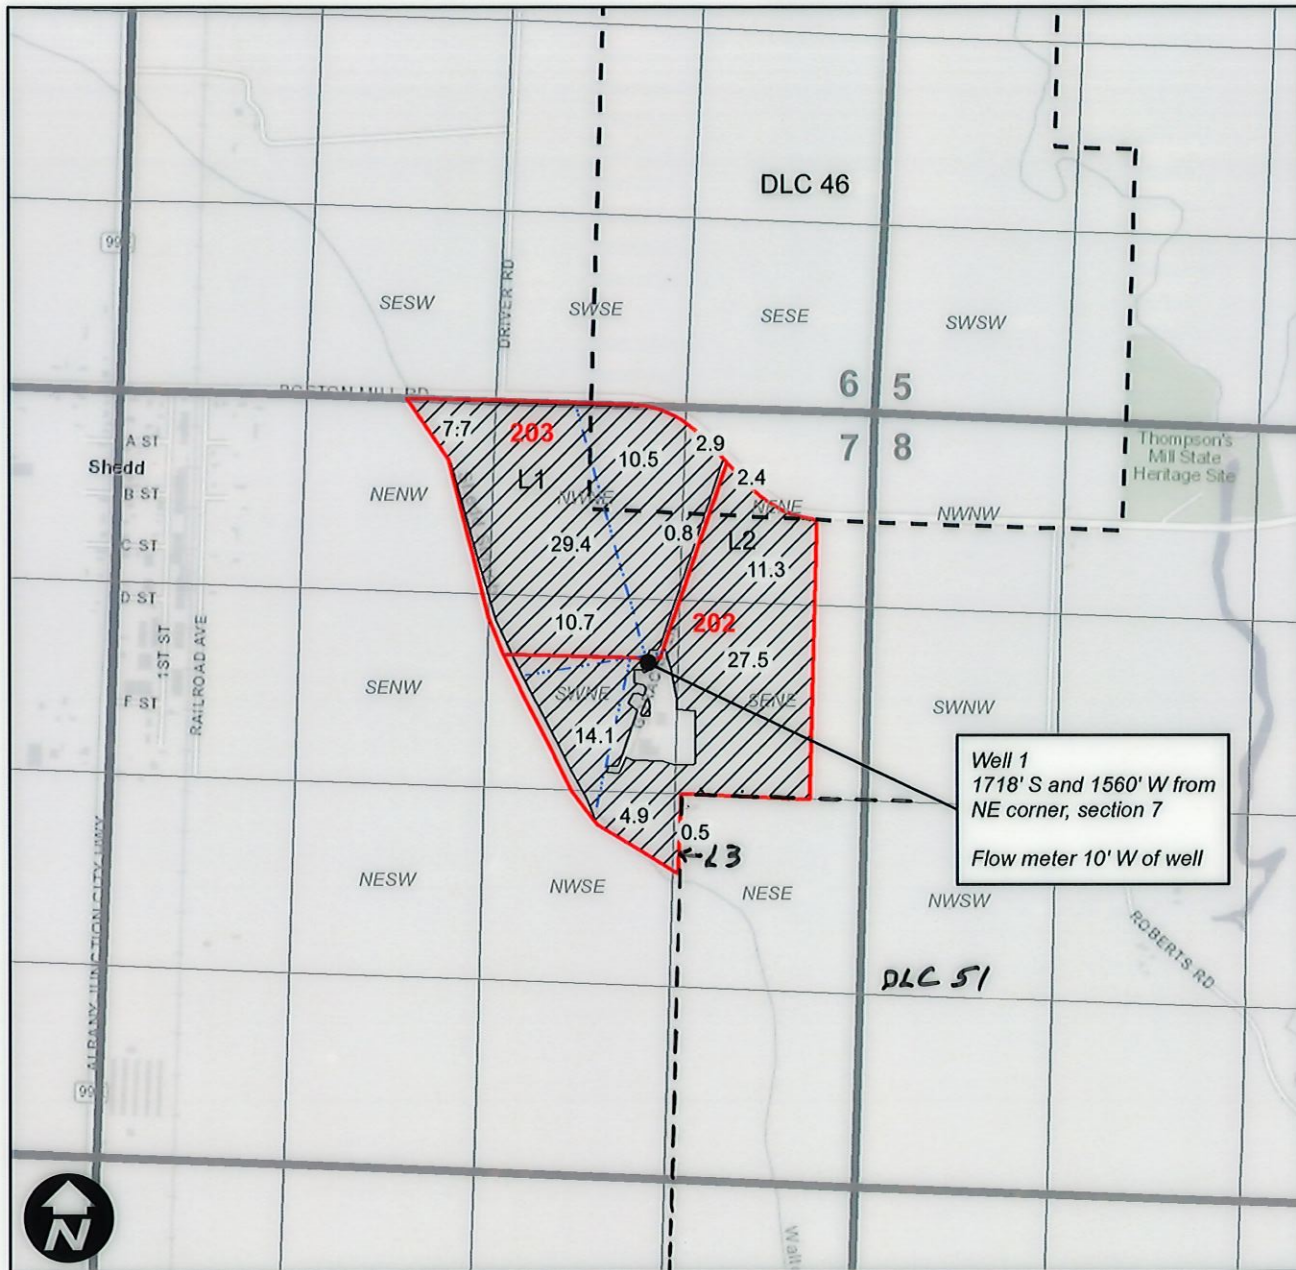

Township 13S, Range 3W, W.M.

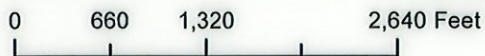

This map is not intended to provide legal dimensions or locations of property ownership lines.



Legend

-  POU
-  Taxlots
-  Mainline
-  DLC



RECEIVED
JUL 07 2023
OWRD

EXPIRES: 12-31-2024