


# Claim of Beneficial Use - Kropf


## Application S-88197, Permit S-55007

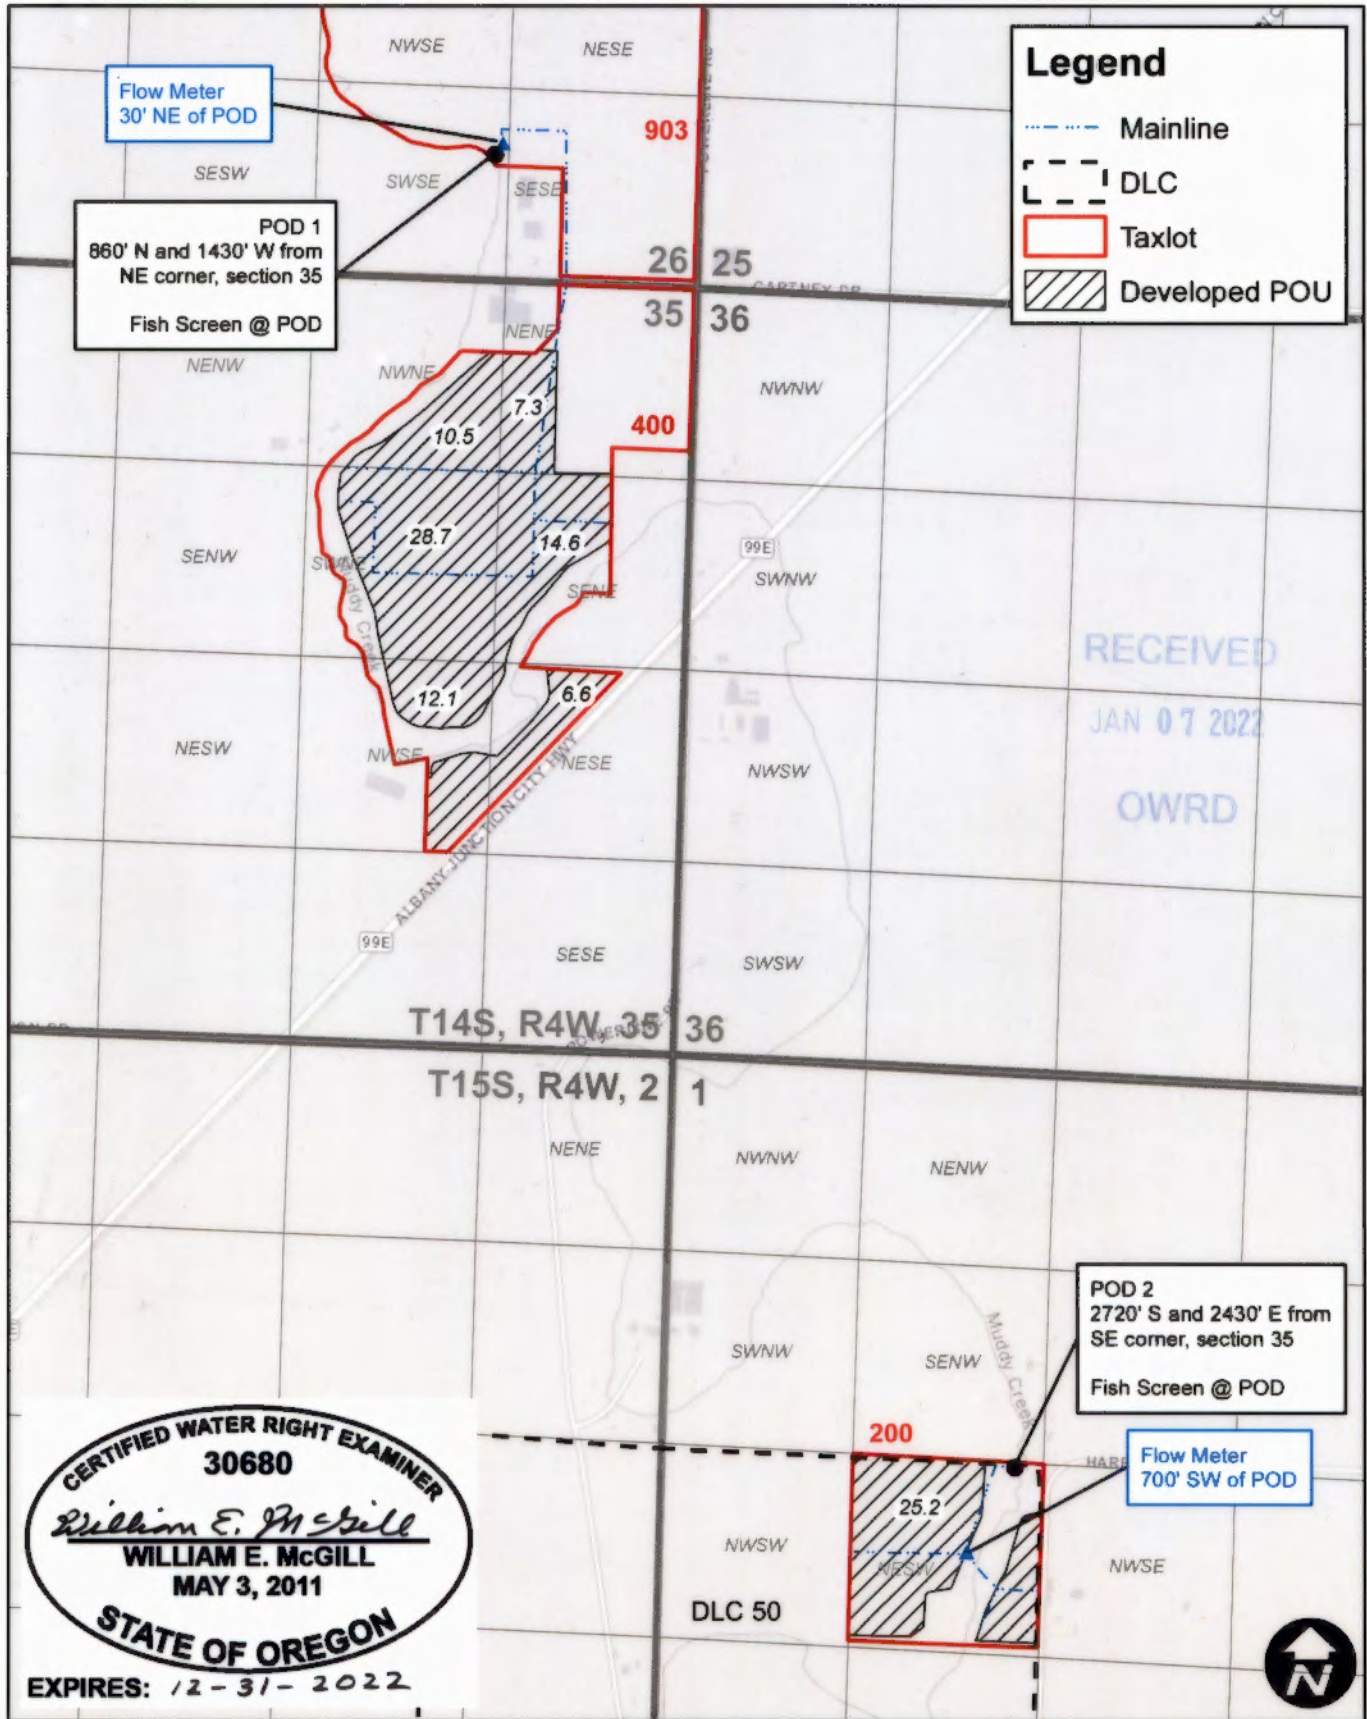

**CERTIFIED WATER RIGHT EXAMINER**  
**30680**  
*William E. McGill*  
**WILLIAM E. MCGILL**  
**MAY 3, 2011**  
**STATE OF OREGON**

**EXPIRES: 12-31-2022**

*This map is not intended to provide legal dimensions or locations of property ownership lines.*

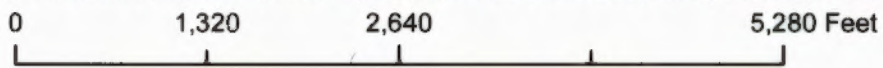

**WILL MCGILL SURVEYING LLC**