


SECTION 35, TWP.3 N. RANGE 17 E. W.M.

SHERMAN COUNTY, OREGON

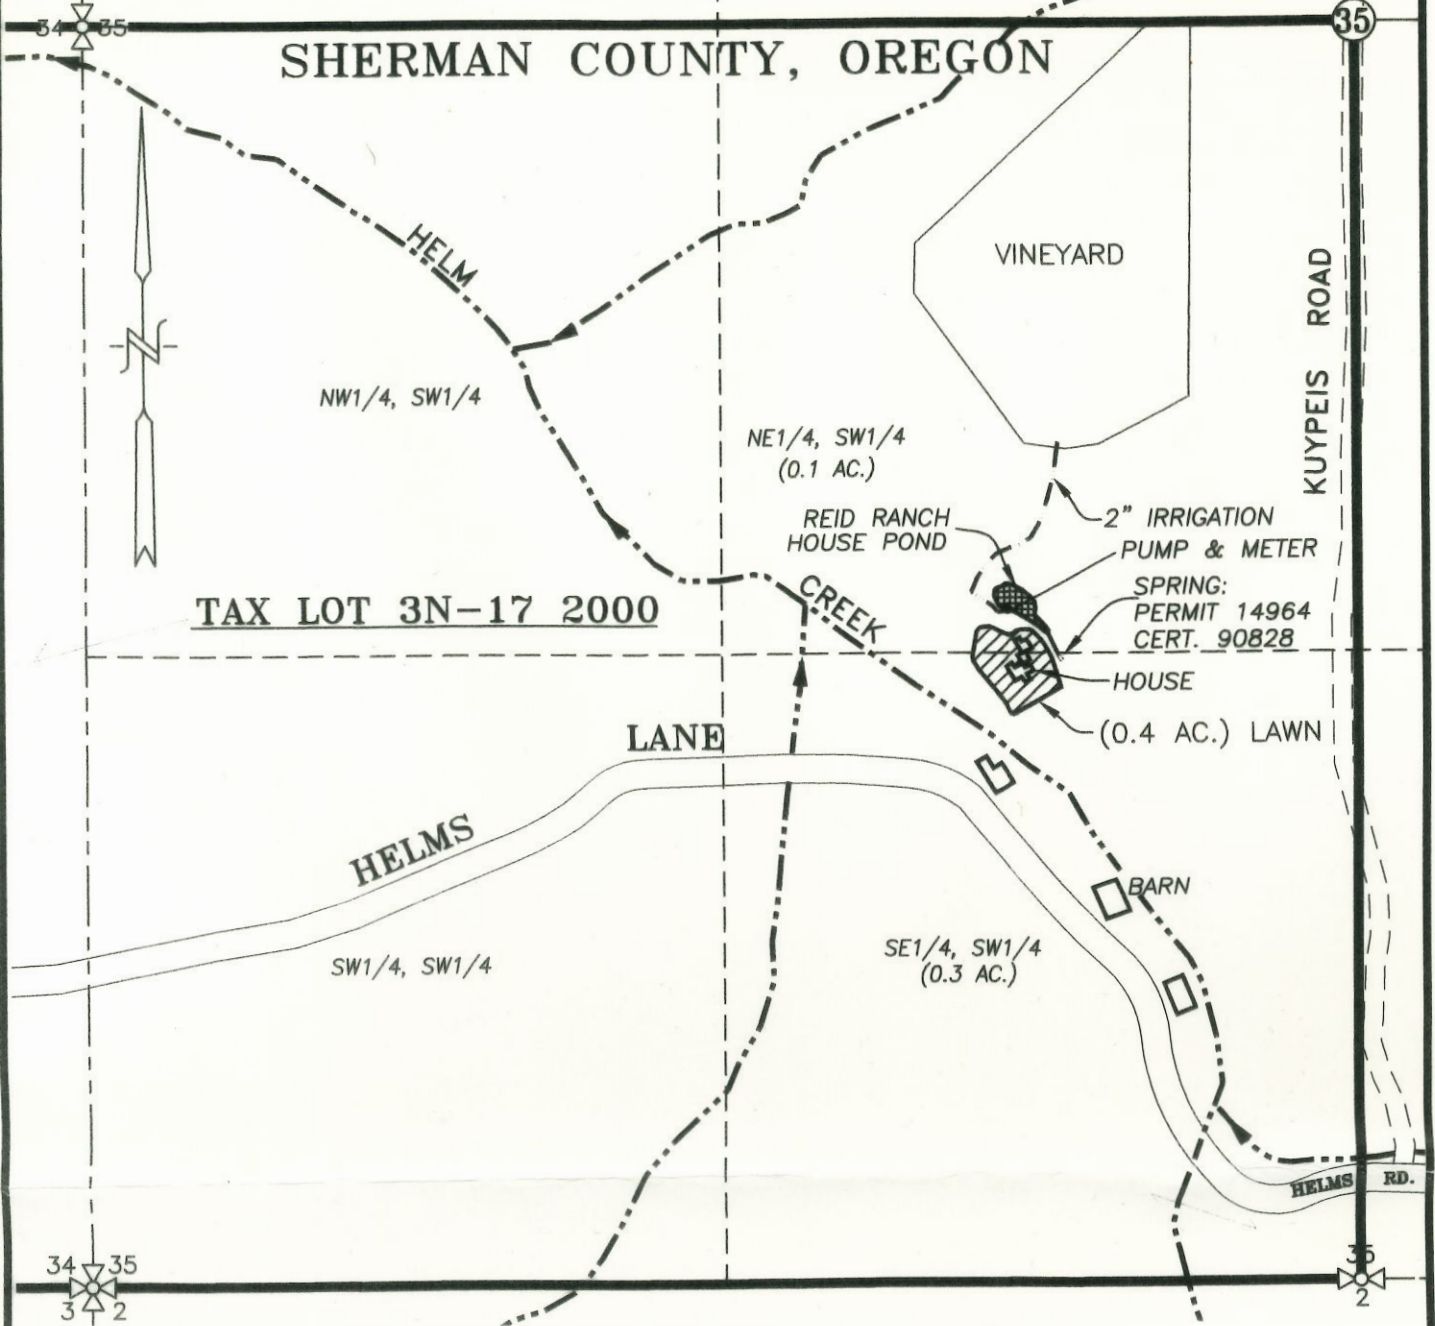

LEGEND:

- POND: 1435' N. & 1930' E. OF SW CORNER SECTION 35
- SPRING: 1310' N. & 2020' E. OF SW CORNER SECTION 35
- ▨ PRIMARY APPLICATION AREA = (0.4) ACRES
- IRRIGATION MAIN
- ~ STREAM WITH DIRECTIONAL FLOW

RECEIVED

JAN 06 2022

OWRD

CLAIM OF BENEFICIAL USE MAP

SCALE: 1" = 400'



APPLICATION No. S-87893

PERMIT No. S-54898


IN THE NAME OF:

REID RANCH, LLC AND SETLZER/JOHNSON TRUST

DATE: NOVEMBER 5, 2021

BY: **TENNESON ENGINEERING CORP.**

3775 CRATES WAY
THE DALLES, OREGON. 97058
PH. 541-296-9177
FAX 541-296-6657

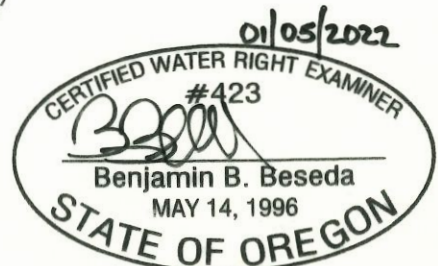

EXPIRES: 12/31/2023

NOTE:

"THIS MAP IS NOT INTENDED TO PROVIDE DIMENSIONS OR LOCATIONS OF PROPERTY OWNERSHIP LINES."

W.O. #14412wr