


CLAIM OF BENEFICIAL USE MAP
 APPLICATION # G-13424 PERMIT # G-12089,
 SECTION 15, TOWNSHIP 32 SOUTH, RANGE 15 WEST, W.M.
 CURRY COUNTY, OREGON

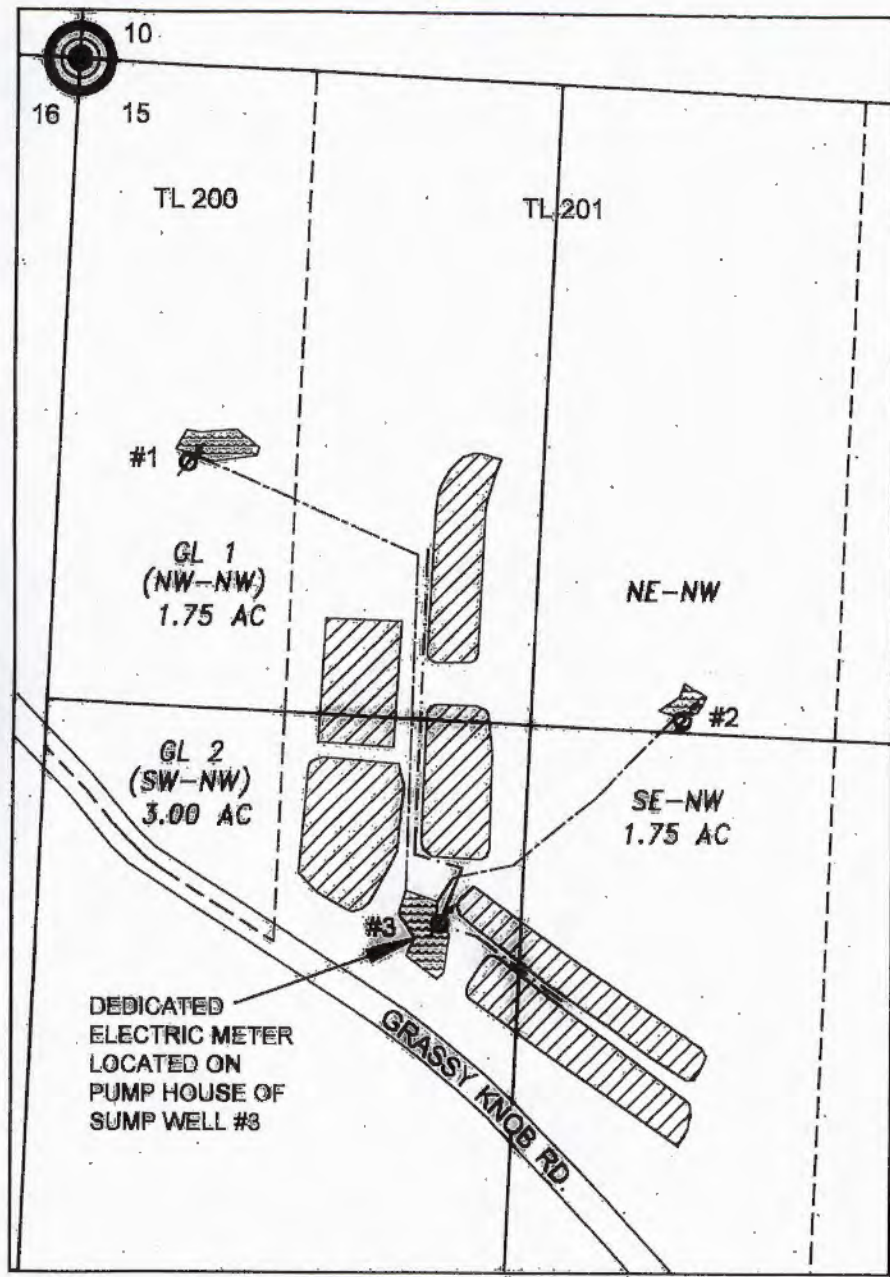

- LEGEND**
- POINT OF BEGINNING (P.O.B.) NW COR. SEC.15 T32S. R15W. W.M.
 - SUMP WELL DIVERSION
 - CONVEYANCE LINE
 - IRRIGATION MAINLINE
 - TAXLOT BOUNDARIES
 - PLACE OF USE
 - SUMP WELL SURFACE AREA
 - GL # GOVERNMENT LOT #

SUMP WELL	SOUTH	EAST
#1	808'	243'
#2	1336'	1247'
#3	1862'	727'

-DISTANCES FROM POB

DISCLAIMER: THIS MAP WAS PREPARED FOR THE PURPOSE OF IDENTIFYING THE LOCATION OF WATER RIGHT ONLY AND IS NOT INTENDED TO PROVIDE LEGAL DESCRIPTIONS OR LOCATIONS OF PROPERTY LINES.

NORTH
 1"=400'

Certified Water Right Examiner
 89189OWRE
Marc J. Van Camp
 Marc J. Van Camp
 May 16, 2019
 STATE OF OREGON
 EXPIRES 06/30/2020

VCC
VAN CAMP
CONSULTING
 P.O. Box 995
 Coos Bay, OR 97420
 (541) 297-1880
 vancampconsulting@gmail.com

Prepared For:
 MICHAEL VON KORFF
 P.O. BOX 222
 SIXES, OR 97476
 Project:
 CLAIM OF BENEFICIAL
 USE MAP
 PERMIT # G-12089
 Date:
 12/04/2019