
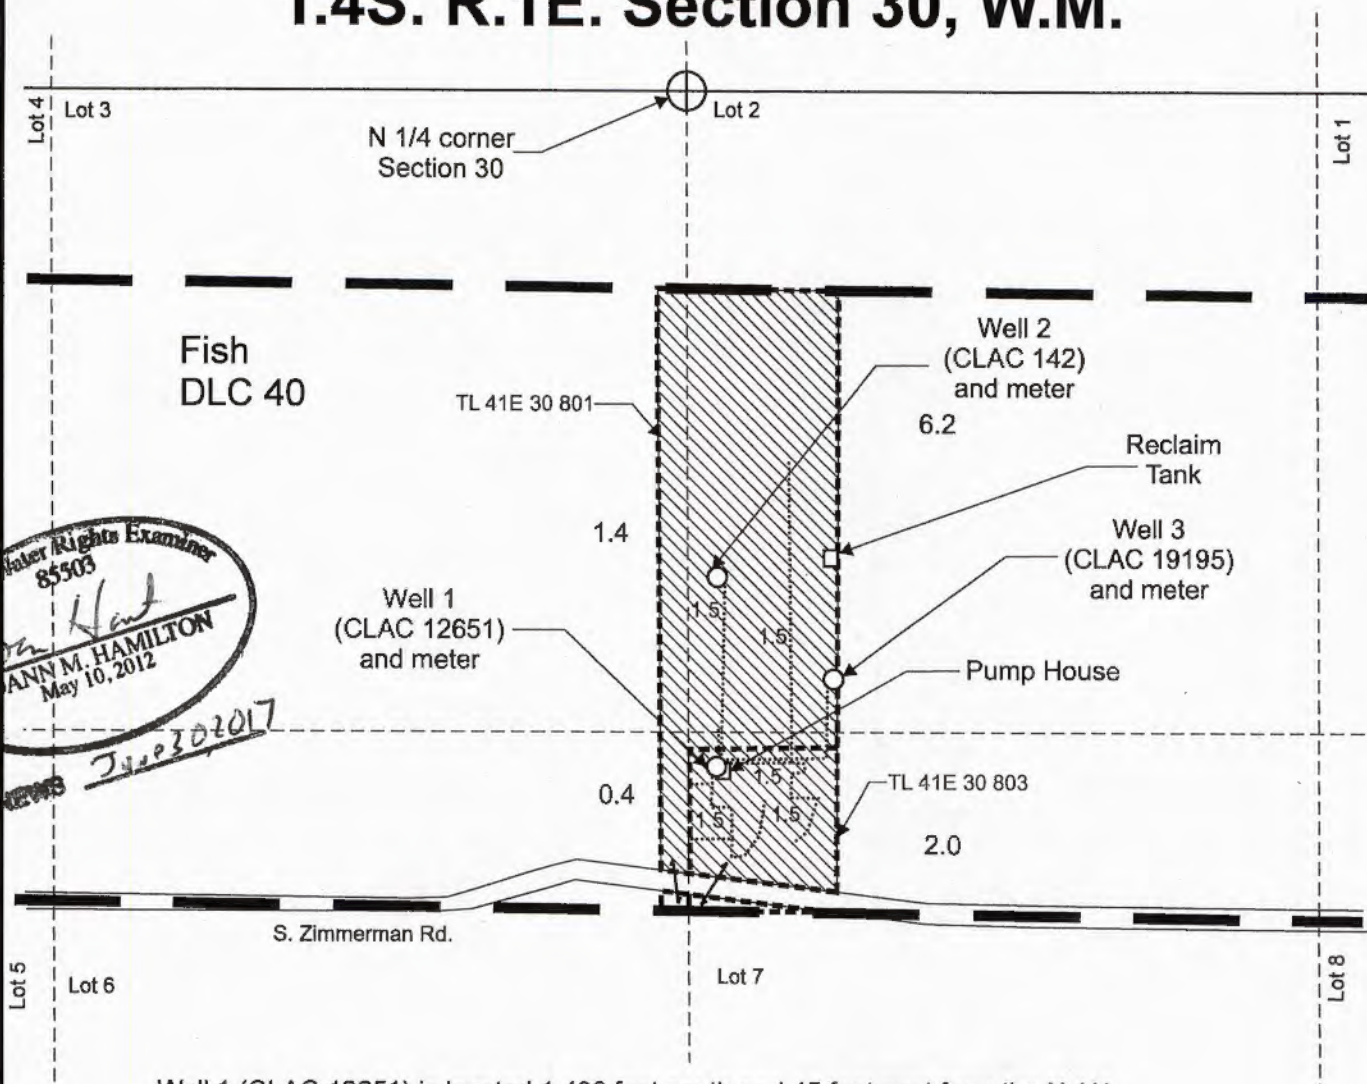


T.4S. R.1E. Section 30, W.M.

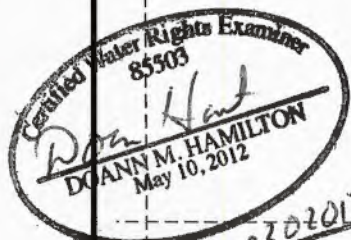

Well 1 (CLAC 12651) is located 1,430 feet south and 45 feet east from the N 1/4 corner, Section 30.

Well 2 (CLAC 142) is located 1,055 feet south and 35 feet east from the N 1/4 corner, Section 30.

Well 3 (CLAC 19195) is located 1,260 feet south and 300 feet east from the N 1/4 corner, Section 30.

Area (10.0 Acres) irrigated under Application G-16506, Permit G-16108.

Tax lot boundary

Donation Land Claim boundary

Irrigation mainlines


RECEIVED

FEB 15 2017

OWRD

This map was prepared for the purpose of identifying the location of a water right only and is not intended to provide legal dimensions or location of property ownership lines.

Scale: 1" = 400'

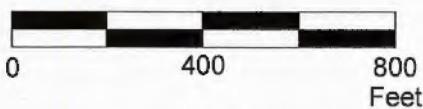

Pacific Hydro-Geology Inc.

Claim of Beneficial Use Map
Application G-16506, Permit G-16108

David and Kristin VanHoose
T.4S. R.1E. Section 30, W.M.

12/2016