

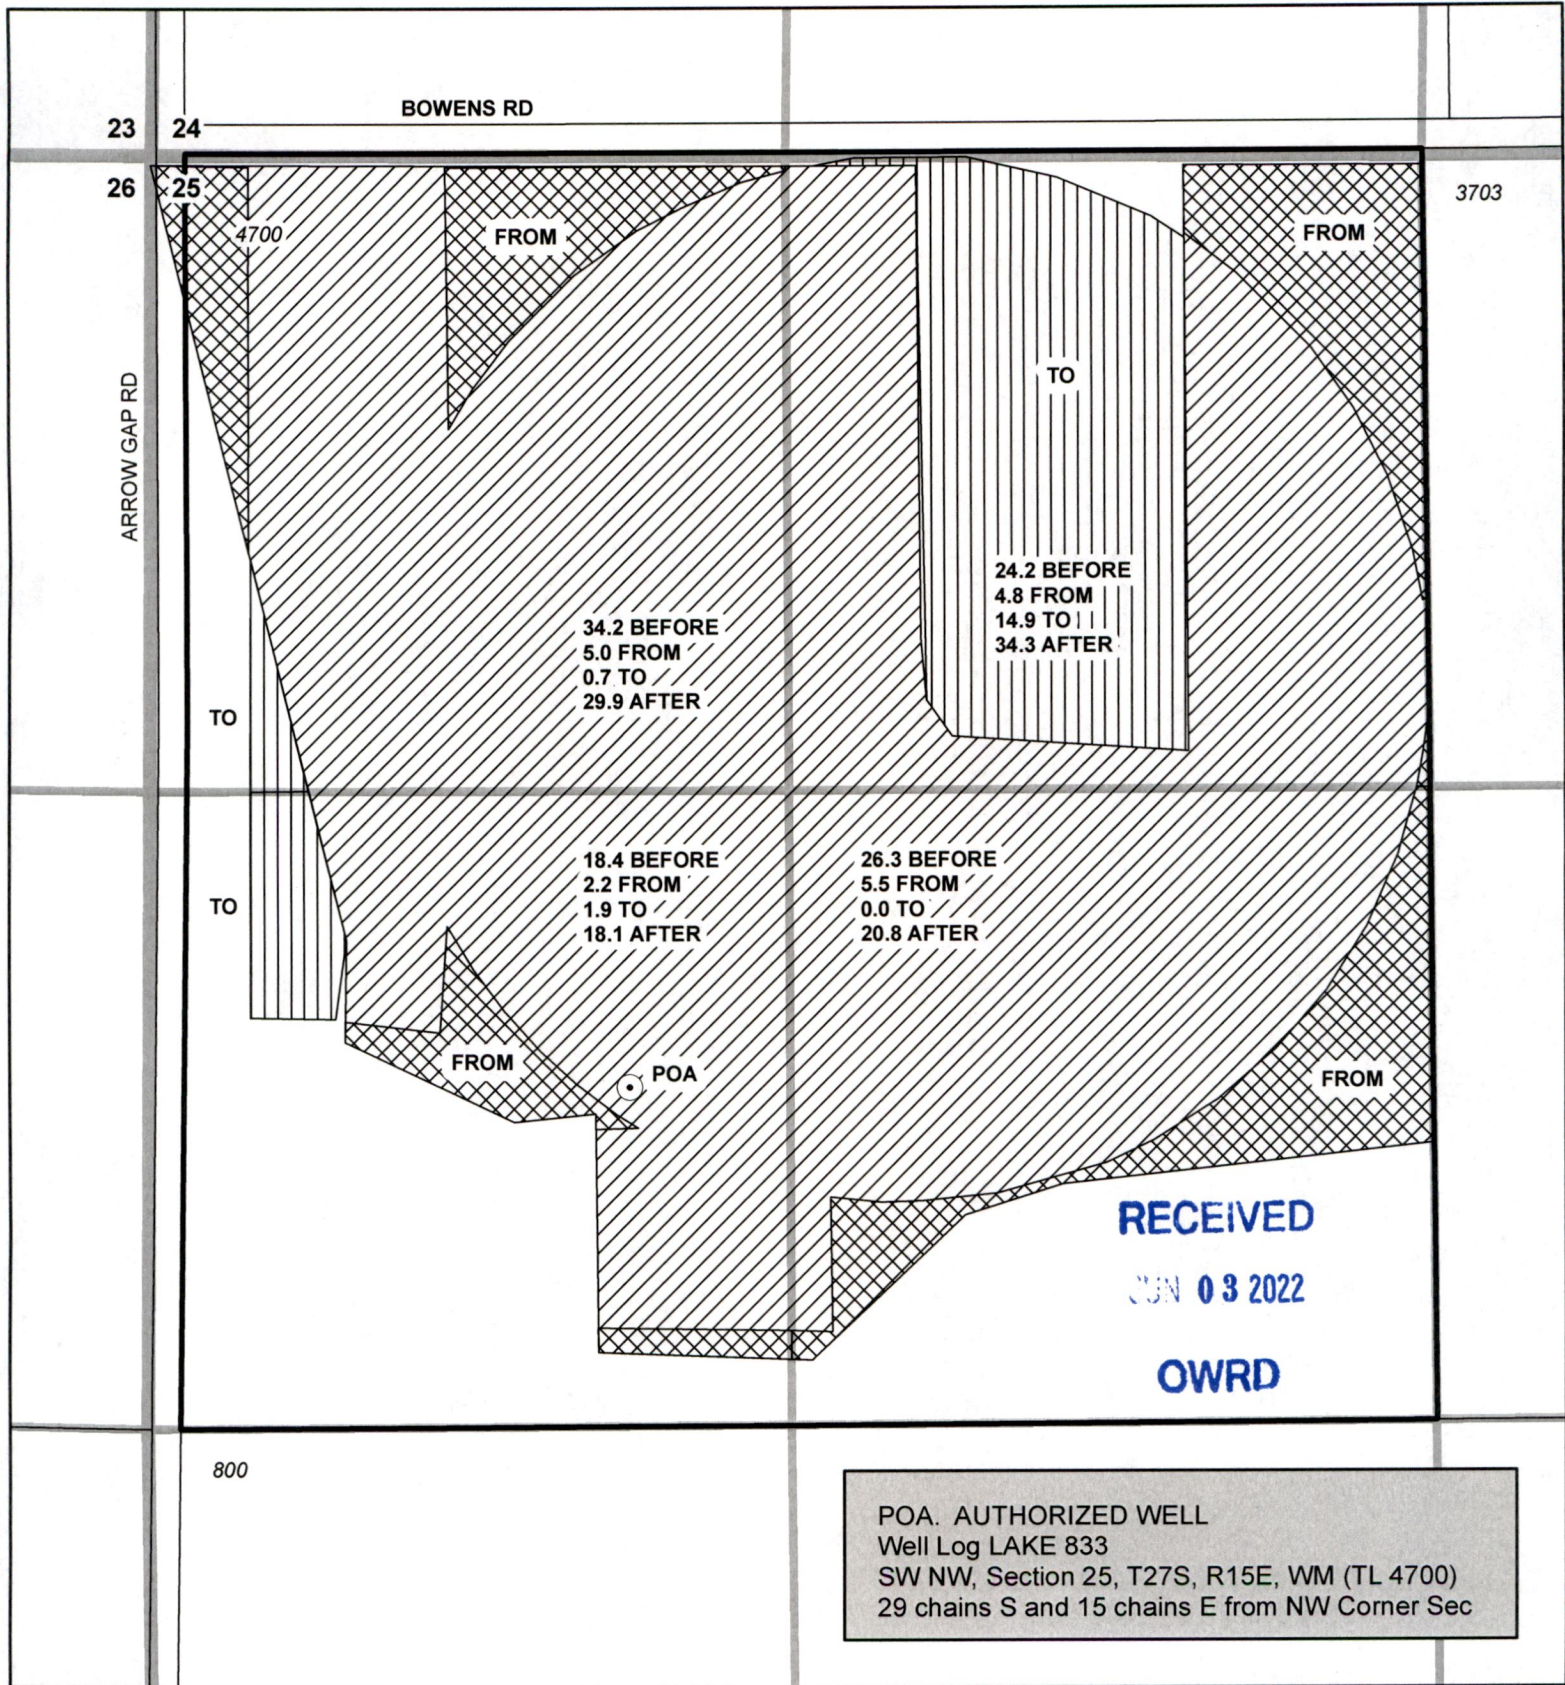


SECTION 25, T27S, R15E, WM -- LAKE COUNTY

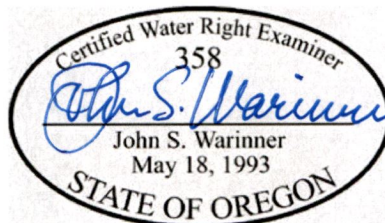


DISCLAIMER
This map is not intended to provide legal dimensions or locations of property ownership lines.

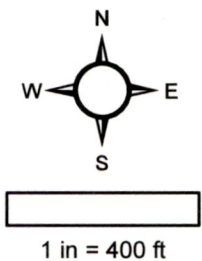

TRANSFER MAP
Certificate 31068
Change Place of Use
in the name of
CAROL CHUGG
Revised 2022-05-18

T.27S. R.15E.W.M.

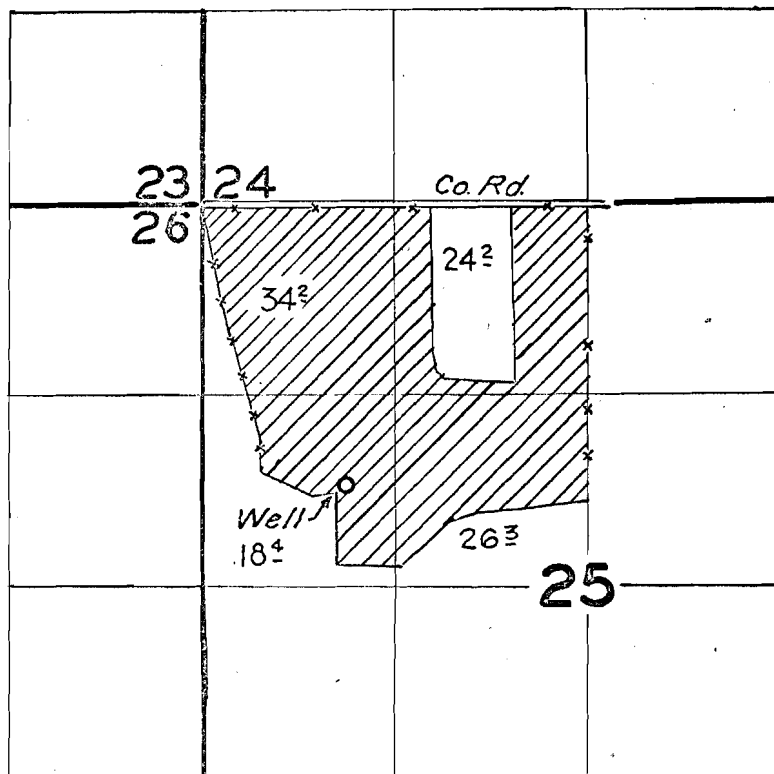

2
34.2
24.2
18.4
26.3
103.0

FINAL PROOF SURVEY
UNDER

Application No. U-765 Permit No. U-706
IN NAME OF

Herman Paul Koehler

Surveyed Sept. 13, 1962, by Carl R. Baker