

CLAIM OF BENEFICIAL USE MAP

FOR: GEORGE B. MCGREGOR
 BY: NATHAN REED, PE, CWRE
 T23S, R8W, W.M. SECTION 11 DLC 40
 APPLICATION NO. S-88006
 PERMIT NO. S-54905



RECEIVED

AUG 13 2021

OWRD


DATE SURVEYED: APRIL 24, 2021

SCALE: 1" = 400'

RECEIVED

SEP 01 2021

OWRD

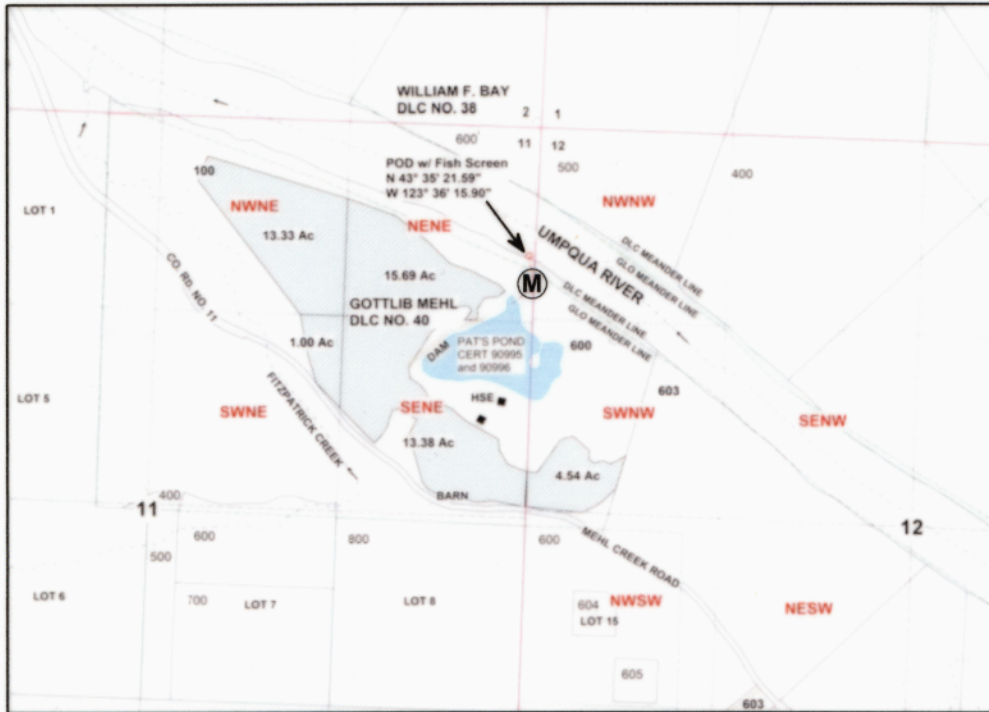


SCALE: 1" = 1320'

POD IS LOCATED 900 FEET SOUTH AND 50 FEET WEST FROM THE NE CORNER, SECTION 11 AS PROJECTED IN DLC NO. 40.

Legend

	Stream		Dam		DLC
	Flow arrow		Structures		Section
	POD		Irrigation Area		Quarter
	Pipeline		Meander		Sixteenth
	Meter		Gov Lot		Parcels

MAP PREPARED FOR:
 GEORGE B. MCGREGOR
 1843 HOTEL CIRCLE SOUTH, SUITE 300
 SANDIEGO, CA 92108

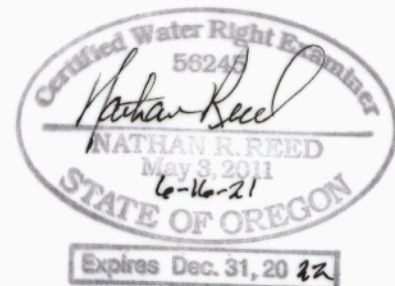

THE PURPOSE OF THIS MAP IS TO IDENTIFY THE LOCATION OF THE WATER RIGHT. IT IS NOT INTENDED TO PROVIDE INFORMATION RELATIVE TO THE LOCATION OF PROPERTY OWNERSHIP BOUNDARY LINES.

MAP PREPARED BY:
 NATHAN R. REED, PE, CWRE
 157 WEST BODIE STREET
 ROSEBURG, OR 97471