

POINTS OF DIVERSION FOR PERMIT S-53428

DATE OF PRIORITY: JANUARY 8, 1992 FOR 150.1 ACRES, AND AUGUST 12, 1996 FOR 20.6 ACRES.

POD 1 - 900 FEET SOUTH AND 1380 FEET WEST FROM NORTHEAST CORNER OF SECTION 5, T40S, R14E, W.M., LOCATED IN THE NW 1/4 NE 1/4 OF SECTION 5

POD 2 - 1700 FEET SOUTH AND 338 FEET EAST FROM NORTHWEST CORNER OF SECTION 16, T40S, R14E, W.M., LOCATED IN THE SW 1/4 NW 1/4 OF SECTION 16

NOTES

1. THE PURPOSE OF THIS MAP IS TO IDENTIFY THE LOCATION OF THE WATER RIGHT ONLY, AND IS NOT INTENDED TO PROVIDE DIMENSIONS OR LOCATION OF PROPERTY LINES.
2. FOR TAX LOT INFORMATION, SEE TAX MAPS INCLUDED WITH THIS APPLICATION.
3. THIS MAP WAS PREPARED FROM FIELD MEASUREMENTS, NAIP 2018 AERIAL PHOTOGRAPH, KLAMATH COUNTY TAX MAP 40 14, 40 14 8, AND 40 14 17.


LEGEND

- TAX LOT BOUNDARY
- - - DITCH LINE
- CREEK LINE
- TOWNSHIP LINE
- SECTION LINES
- - - 1/4 1/4 LINES
- LAKE BOUNDARY
- GRAVEL/DIRT ROADWAY
- - - ABOVEGROUND PIPE
- 9.2 SENE IRRIGATED ACREAGE
- 1/4 1/4
- TL 500 TAX LOT NUMBER
- SUITABLE MEASURING DEVICE
- POINT OF DIVERSION
- SECTION CORNER
- FLOW DIRECTION
- PUMP

Received by OWRD

MAR 21 2024

Salem, OR

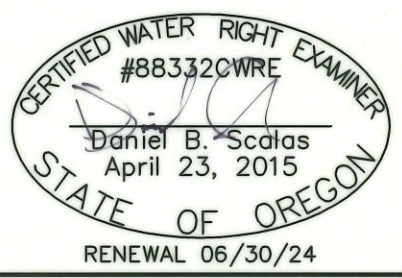

ALADKINS ENGINEERING & SURVEYING
 o / 541.884.4666 w / AdkinsEngineering.com
 1435 ESPLANADE AVENUE, KLAMATH FALLS, OR 97601

SERVING S. OREGON & N. CALIFORNIA

CLAIM OF BENEFICIAL USE AND FINAL PROOF MAP
 FOR
 MICHAEL & DIANE TYRHOLM
 T40S, R14E, SEC. 8 & 17, W.M.
 KLAMATH COUNTY, OREGON
 PERMIT S-53428
 APPLICATION S-72129

COPY MAP #1300