



Transfer Application T-8290

Claim of Beneficial Use

Township 5S, Range 1W, W.M.

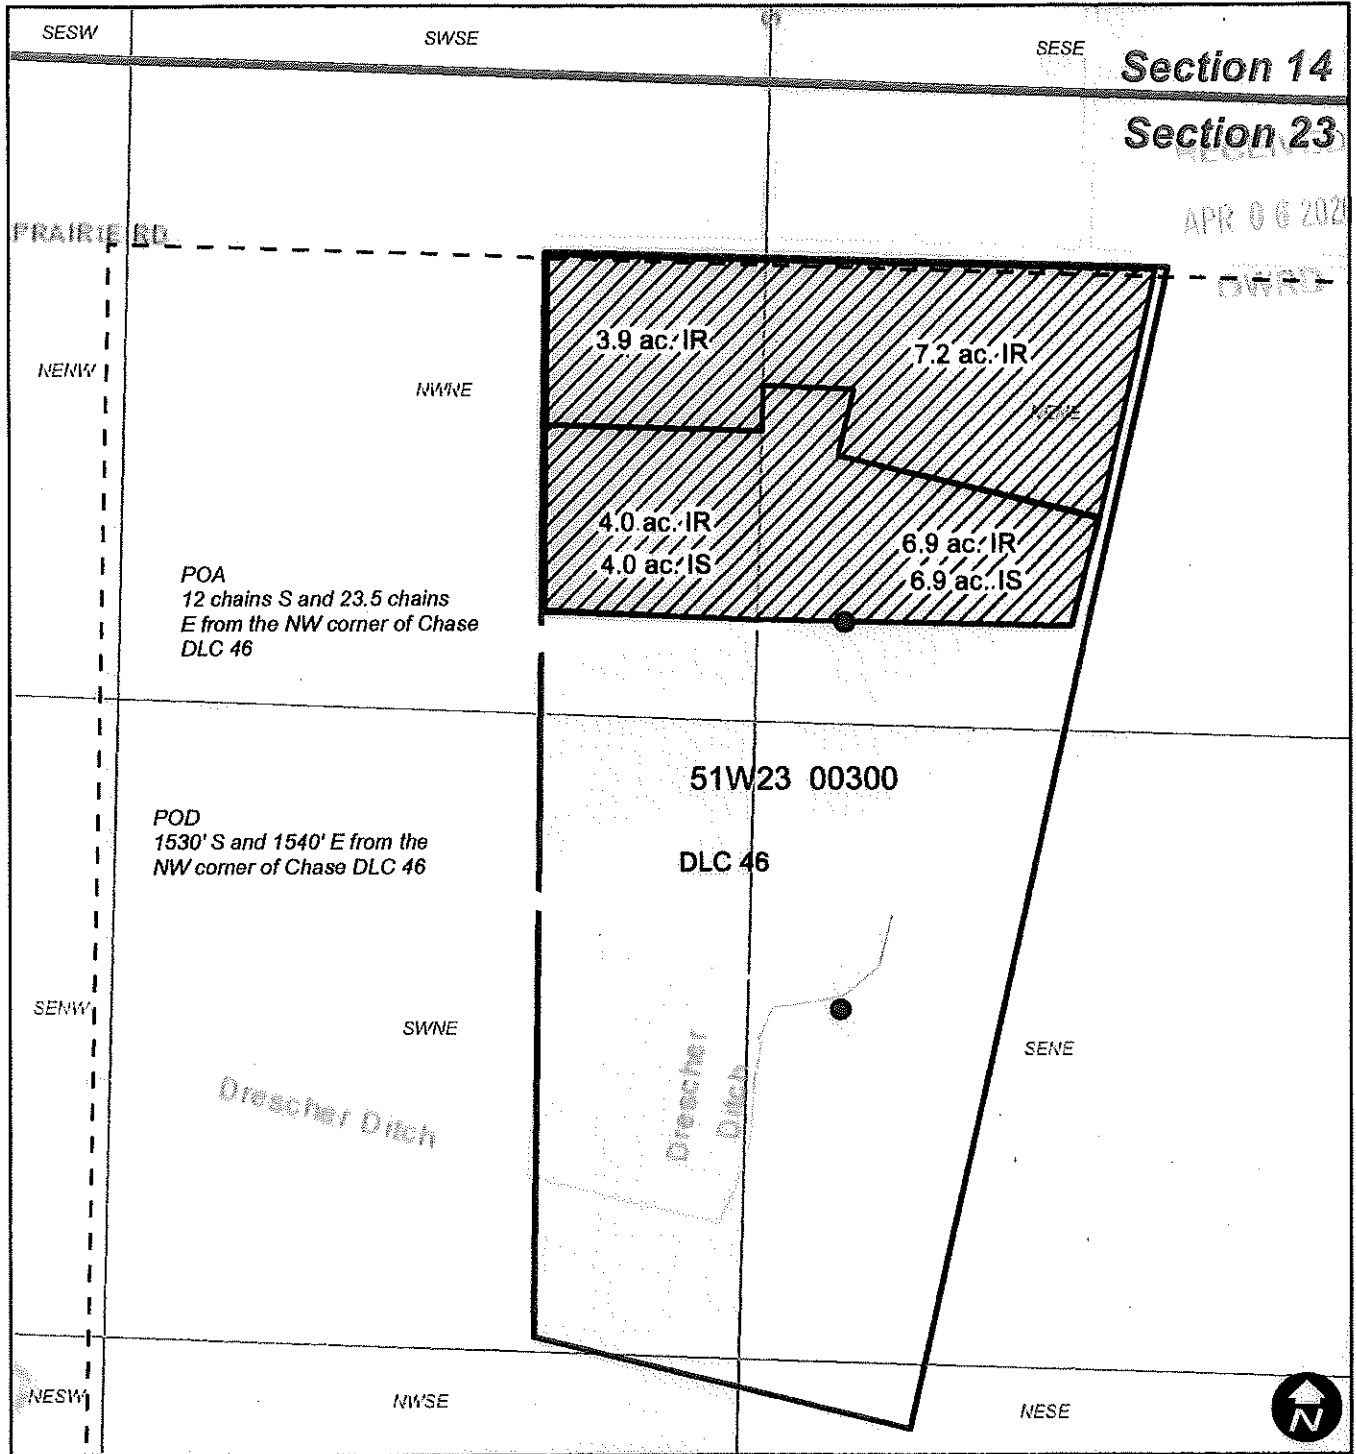



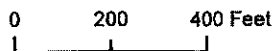
APR 06 2021



This map is not intended to provide legal dimensions or locations of property ownership lines.

Legend

-  Place of Use
-  Tax Lot
-  DLC



EXPIRES: 12/31/2020