


T11S.R.2W.W.M.

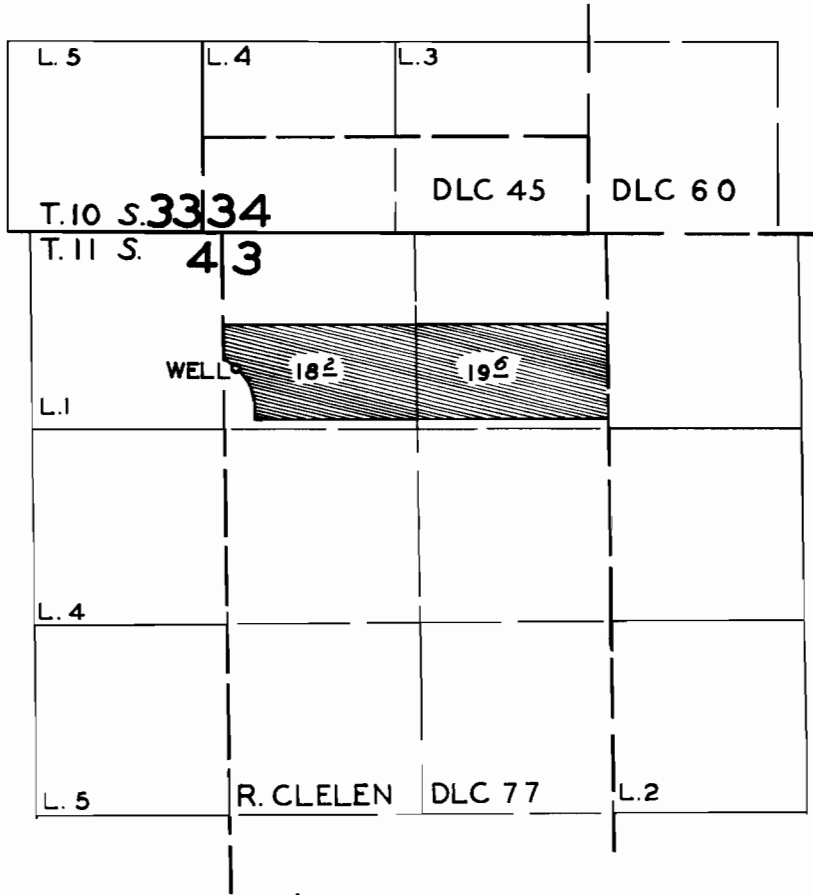

FINAL PROOF SURVEY UNDER


Application No. G 626 Permit No. G 538
IN NAME OF

SAM & OPAL LOONEY

Surveyed OCT. 13, 1960, by R. H. JACKSON

RECEIVED
MAY 26 2022

Certificate 28702 - Transfer Application

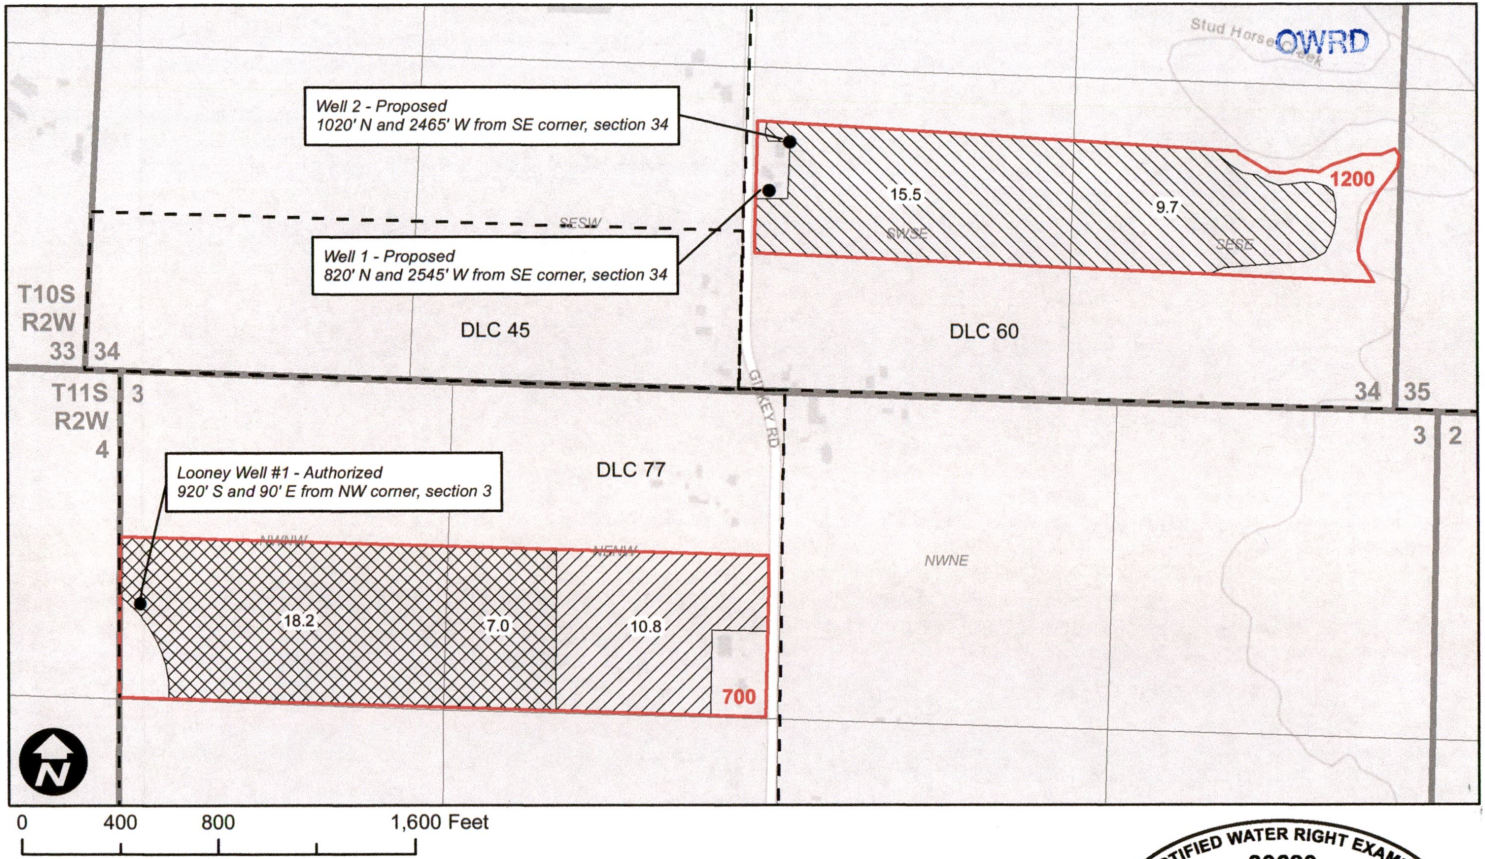

Legend

- Transfer From
- Cert. 28702 No Change
- Transfer To
- Tax Lot
- DLC

WILL MCGILL SURVEYING LLC

CERTIFIED WATER RIGHT EXAMINER
30680
William E. McGill
WILLIAM E. MCGILL
MAY 3, 2011
STATE OF OREGON
EXPIRES: 12-31-2022
14018