


8614
9776

Sec. 5
17
20
21

Tp. 36 S
R. 4 E

Opp. Klamath Jk. Misc.

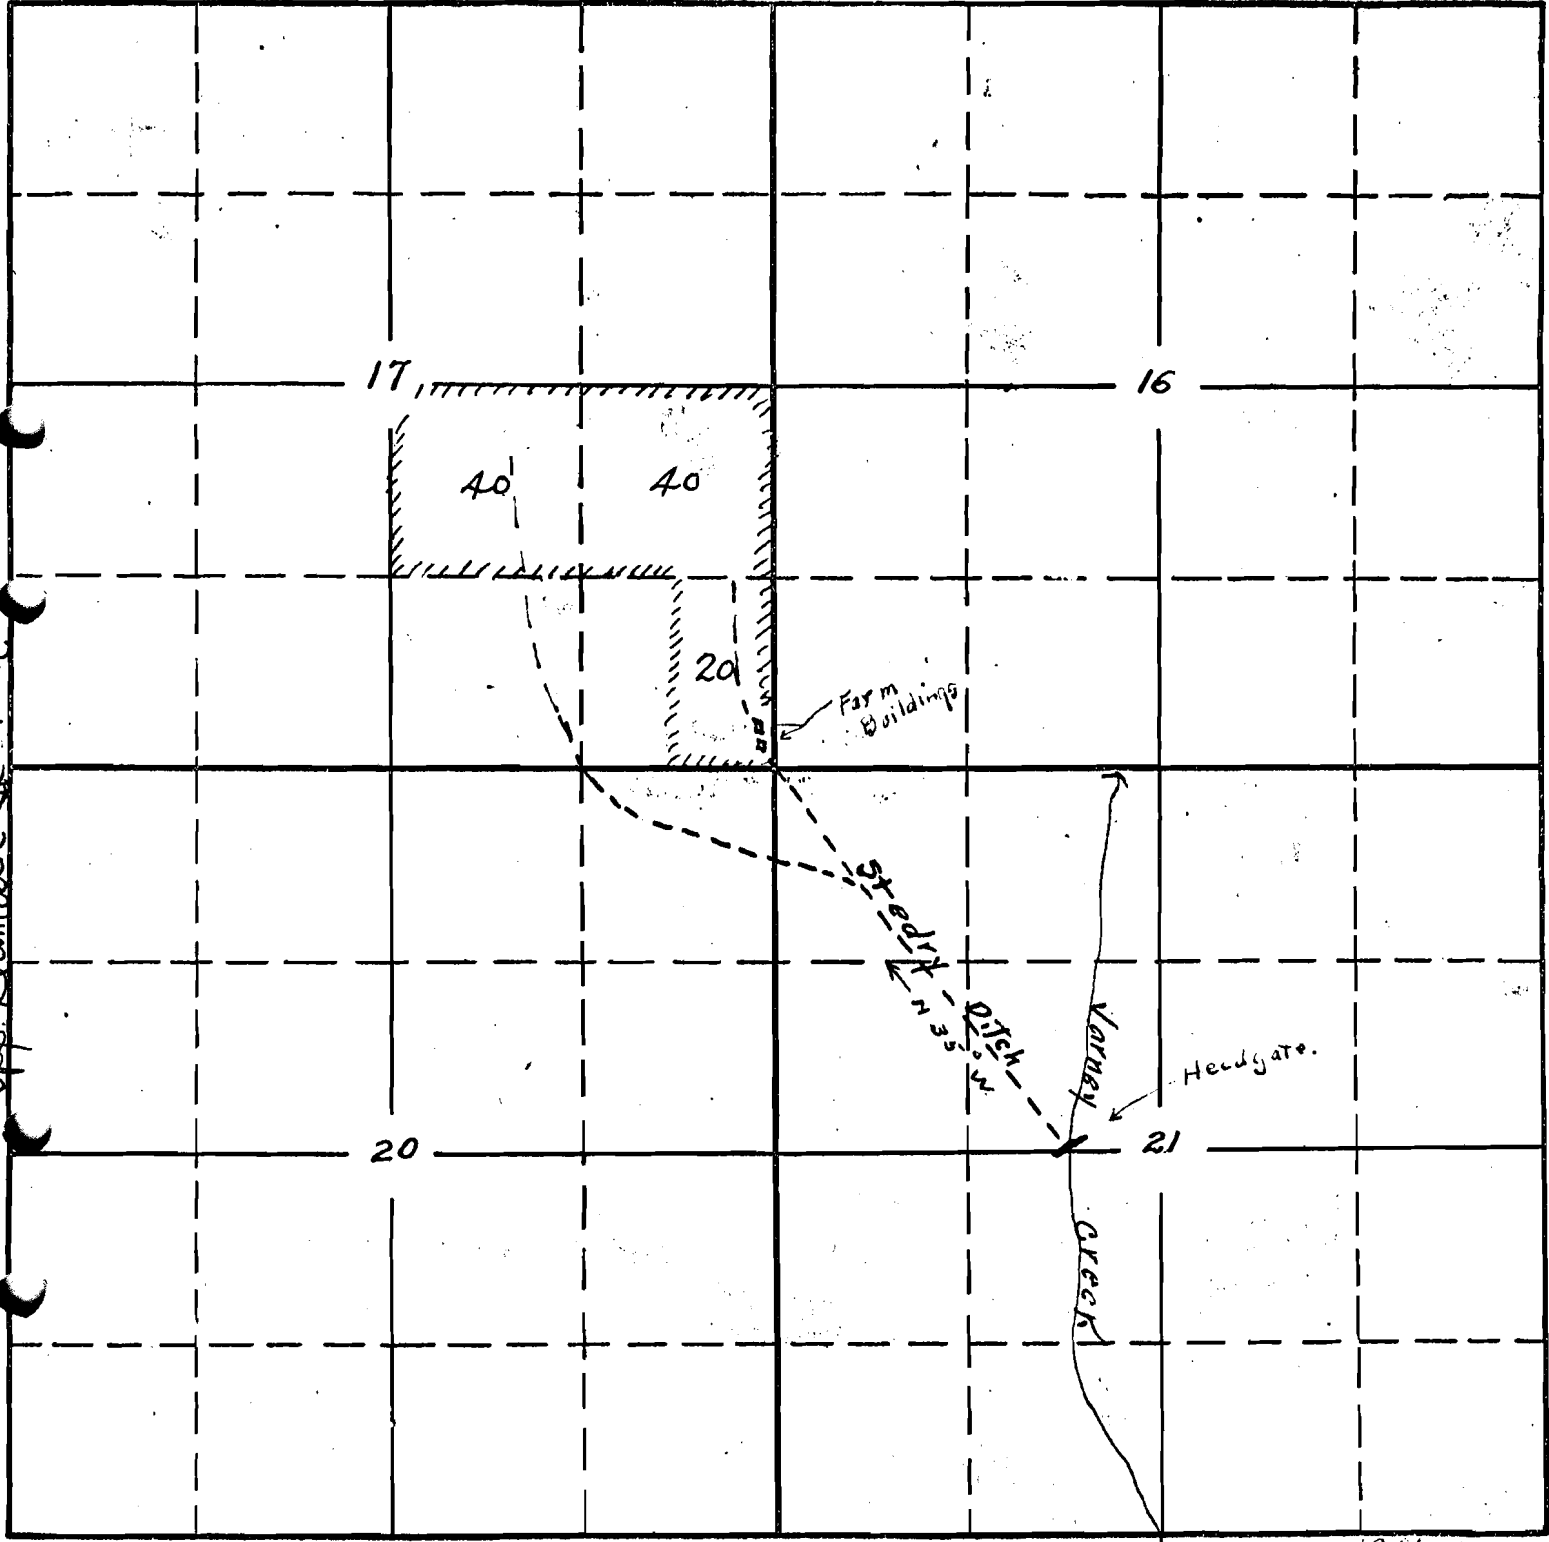

H.S. Dbye
Forest Ranger
7/14/28

Application No. 12201
Permit No. 8614